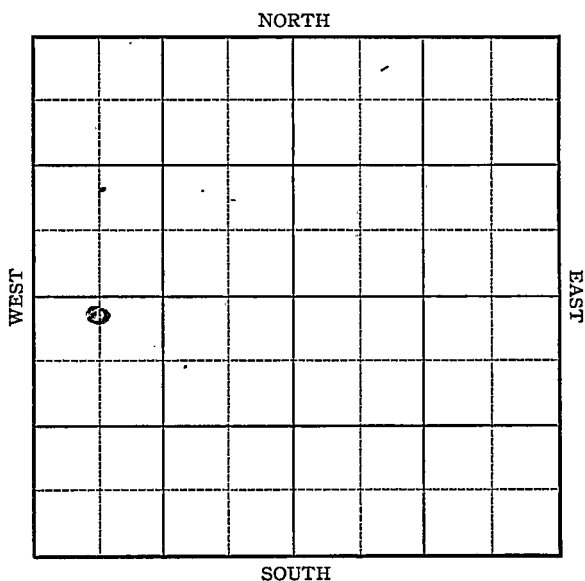


KANSAS

Rice

Section 19 Township 19 Range 10WWell No. 1 BellCompany Wood River Oil & Refining

KANSAS

Rice

Sec. 19 Twp. 19 R. 10-W

Well No. #1 Doll Farm

Wood River Oil & Refining Company


Chase Pool

330 Ft. from N. Line

 Ft. from S. Line

 Ft. from E. Line

660 Ft. from W. Line

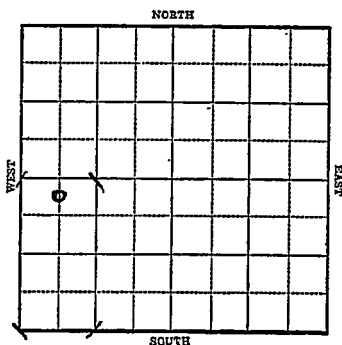

1942

R E P O R T

10/21 Rotary

10/28 8"

11/4 8" @ 213
Drlg. 1860

11/11 Drlg. 2862'

11/18 Lans 3011 S Gas
BKC 3274
Arp 3301

SSD 3309-14

TD Run 5"

11/24 Arb. 3307 corrected
5" @ 3369'
TD 3370' Rust.

12/2 Arb. 3307
5" @ 3369
T.D. 3370'
48 shots 3318-33
Echo Pot. 3250
Max. 3000
Gravity 81.4

COMPLETED


Rice

KANSAS

Map No. 46 Sec. 19 Twp. 19 R. 10WWell No. 1 DollWood River Oil & Refining Company**FIRST REPORT**

Contractor

C NL NW SW

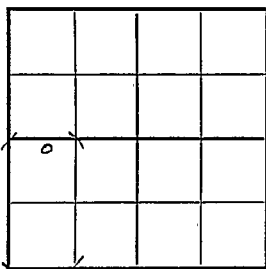SECTION PLAT330 Ft. from N. Line Ft. from S. Line Ft. from E. Line660 Ft. from W. Line**CHASE POOL**Location Rig up

Drilling and Remarks:

Rotary

RECORDCased in., ft.Sand Gas Oil Total Depth **PRODUCTION**1st 24 hrs. Nat. 1st 24 hrs. after shot Gas Cu. Ft.Dry Hole Abandoned

Date

OCT 21 1942

19

S. J. LEWIS

Scout

Misc. Small Maps	<i>Ind</i>
Cards	<i>Boat</i>
Tracing	<i>MB</i>
France Map	<i>MB</i>
Scarborough Map	<i>MB</i>
Moody Map	<i>MB</i>
Geological Dept.	
Moody Plat Book	

Rice

KANSAS
 Map No. 46 Sec. 19 Twp. 19 R. 10W

Well No. 1 Doll

Wood River Oil & Refining Company

COMPLETED

Contractor

C NL NW SW

SECTION PLAT

o			

330 Ft. from N. Line

Ft. from S. Line

Ft. from E. Line

660 Ft. from W. Line

SILICA POOL

Location

Rig up

Drilling and Remarks:

*Cur 83307**5" @ 3369**48 to hole 3318-23**Echo P. 83250**Max 3000**412 gr*

RECORD

Cased _____ in., _____ ft.

Sand _____

Gas _____

Oil _____

Total Depth 3320

PRODUCTION

1st 24 hrs. Nat. _____

1st 24 hrs. after shot _____

Gas _____ Cu. Ft.

Dry Hole _____

Abandoned _____

Date

DEC 2 1942 19

S. J. LEWIS Scout

Misc Small Maps *Sh*
Cards *Bar*
Tracing *MB*
France Map *MB*
Scarborough Map *MB*
Moody Map *MB*
Geological Dept.
Moody Flat Book