


Section 19 Township 19 Range 10-W

Well No. #1 Doll "B"

Company Cities Service Oil

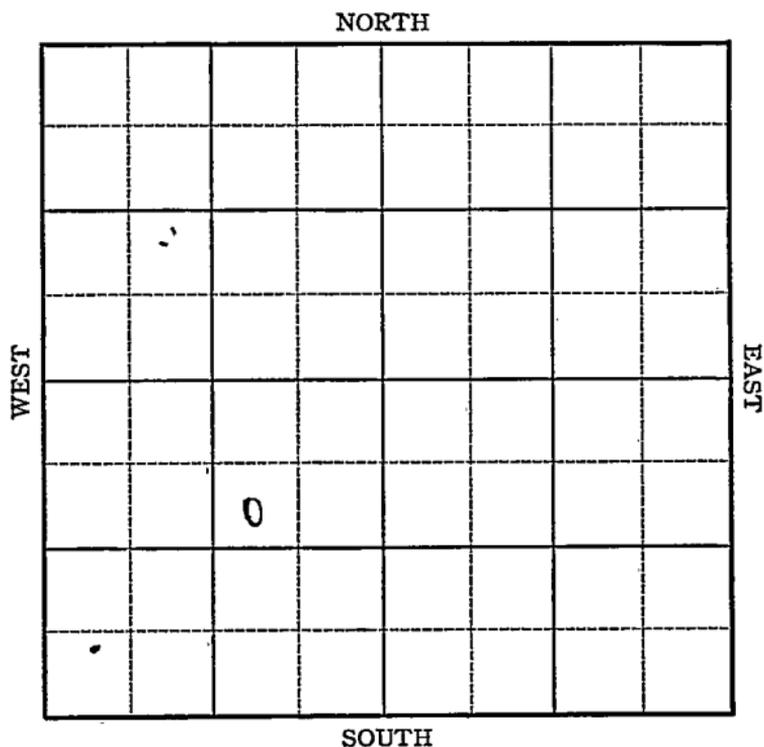

Sec. 19 Twp. 19 R. 10-W

Well No. #1 Doll "B" Farm

Cities Service Oil Company


990 Ft. from N. Line

\_\_\_\_\_ Ft. from S. Line

990 Ft. from E. Line

\_\_\_\_\_ Ft. from W. Line

*elev. 1772*

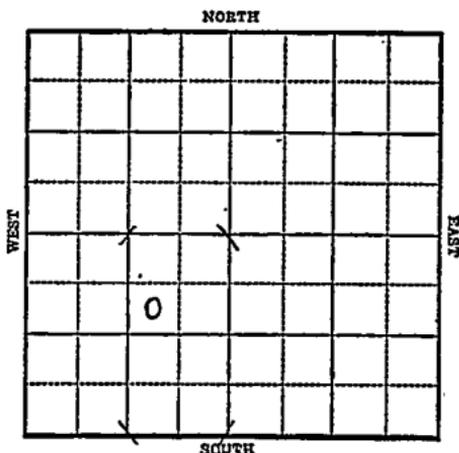

1943

**R E P O R T**

5/19 Location

5/26 8" @ 226 WOC.

6/2 Drlg. 2970'

6/9 Lans 3008  
Arb 3290-95 T.D.  
5" @ 3291 Rust

6/16 T.D. 3298-3040' oil 13/4hrs.

6/23 Arb. 3290  
5" @ 3291'  
T.D. 3298' -  
Echo Pot 12883  
Max. 3000  
Gravity 42.4

**COMPLETED**

KANSAS

Rice

Map No. 46 Sec. 19 Twp. 19 R. 10W

Well No. 1 Doll "B"

Cities Service Oil Company

FIRST REPORT Contractor

SW NE SW


SECTION PLAT

990 Ft. from N. Line

\_\_\_\_\_ Ft. from S. Line

990 Ft. from E. Line

\_\_\_\_\_ Ft. from W. Line

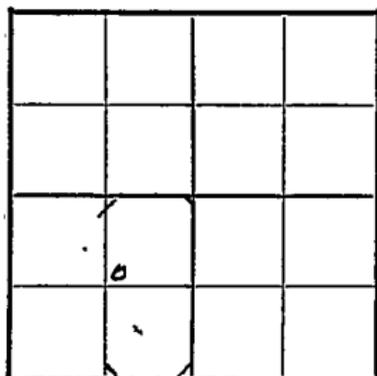

SILICA POOL

Location XXX

Rig up \_\_\_\_\_

Drilling and Remarks:

RECORD

Cased \_\_\_\_\_ in., \_\_\_\_\_ ft.

Sand \_\_\_\_\_

Gas \_\_\_\_\_

Oil \_\_\_\_\_

Total Depth \_\_\_\_\_

PRODUCTION

1st 24 hrs. Nat. \_\_\_\_\_

1st 24 hrs. after shot \_\_\_\_\_

Gas \_\_\_\_\_ Cu. Ft.

Dry Hole \_\_\_\_\_

Abandoned \_\_\_\_\_

Date

MAY 19 1943 19

S. J. LEWIS

Scout

**KANSAS**

Map No. 46 Sec. 19 Twp. 19 R. 10W

Well No. 1 Doll "B"

Cities Service Oil Company

**COMPLETED** Contractor

SW NE SW

SECTION PLAT

990 Ft. from N. Line

\_\_\_\_\_ Ft. from S. Line

990 Ft. from E. Line

\_\_\_\_\_ Ft. from W. Line

	o		

**SILICA POOL**

Location \_\_\_\_\_

Rig up \_\_\_\_\_

Drilling and Remarks:

*Cr 3290*  
*5" 3291*  
*Echo Prod 12823*  
*Map 3000*

*42 1/2*

**RECORD**

Cased \_\_\_\_\_ in., \_\_\_\_\_ ft.

Sand \_\_\_\_\_

Gas \_\_\_\_\_

Oil \_\_\_\_\_

Total Depth 3298

**PRODUCTION**

1st 24 hrs. Nat. \_\_\_\_\_

1st 24 hrs. after shot \_\_\_\_\_

Gas \_\_\_\_\_ Cu. Ft.

Dry Hole \_\_\_\_\_

Abandoned \_\_\_\_\_

Date

JUN 23 1943 19

**S. J. LEWIS** Scout