

Well No. #1 Hedstrom

Company Woodriver Oil & Ref.

24

WEST

EAST

0


SOUTH

McPherson

KANSAS

Sec. 19 Twp. 19 R. 2WWell No. #1 Hedstrom FarmWoodriver Oil & Ref. CompanyMallard Drlg. ContractorChindberg Pool. Ft. from N. Line330 Ft. from S. Line990 Ft. from E. Line Ft. from W. Line

SW SE SW

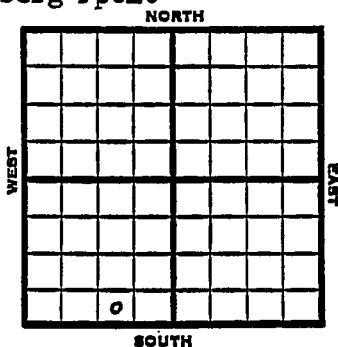

1953

Elev. 1512'

REPORT

7/22

Spud 7-17-53

8" @ 187'

Drlg 1230'

7/29

D&A

8/5

Spud 7-17-53

8" @ 187'


Miss 3007'

TD 3025'

D & A

ABANDONED

County McPherson State Kansas
 Sec. 19 (Blk. Twp.) 19 (Sur. Rge.) 2W Map No. _____
 Operator Woodriver Oil & Ref.
 Well No. 1 Farm Hedstrom
 Elev. 1512 Location SW SE SW

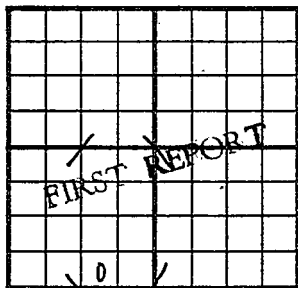

330 Ft. From S Line SW
990 Ft. From E Line Quarter

Ist. Report JUL 22 1953

Completion _____

Remarks _____

Mallard Drlg. - Contr.

Spudding Date 7-17-53

Drlg. Data _____

Chindberg Pool

8" @ 187 drlg. 1230

J. G. McGEHEE

County McPherson State Kansas

Sec.	19	(Blk.) Twp.)	19	(Sur.) Rge.)	2W	Map No.
------	----	-----------------	----	-----------------	----	---------

Operator Woodriver Oil & Ref.

Well No. 1 Farm Hedstrom

Elev.	1512	Location	SW SE SW
-------	------	----------	----------

~~ABANDONED~~

330 Ft. From S Line SW

990 Ft. From E Line Quarter

1st. Report

Completion AUG 5 1953

Remarks Chindberg Pool

Mallard Drlg. - Contr.

Spudding Date 7-17-53

Drlg. Data

8" @ 187 Miss. 3007 TD 3025

D & A

J. G. McGEHEE