


Section 19 Township 19 Range 13WWell No. #1 L. GunnCompany Transit Corp.

NORTH

7

WEST

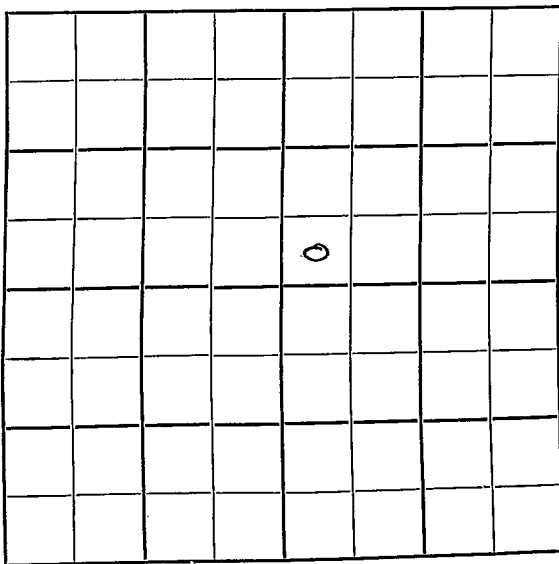

EAST

SOUTH

Barton

Sec. 19 Twp. 19 R. 13WWell No. #1 L.-Gunn FarmTransit Corp. CompanyTransit Corp. ContractorWildcat


Ft. from N. Line

330 Ft. from S. Line

Ft. from E. Line

330 Ft. from W. LineNE  $\frac{1}{4}$  SW SW NE

Sun &amp; Amerada support

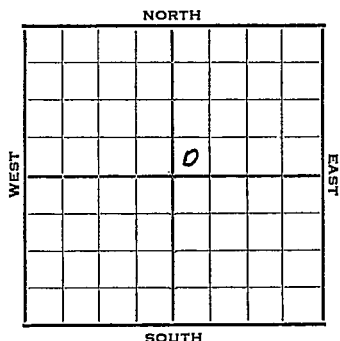

1952 Elev. 1859' REPORT

10/29 Spud 10-25-52  
Anhy 759'  
8" @ 770'  
Drlg. 965'

11/5 Heeb 3073', Tor 3087' SS0,  
Douglas 3102', Br li 3173', Lans  
3191'  
DST 3175-3233, 50 mins., 10' m  
0#  
DST 3175-3233, 50 mins., 0#  
Drlg. 3381

11/12 Spud 10-25-52  
D&A  
TD 3565'  
Anhy 759  
8" @ 770  
Heeb. 3073', Tor. 3087', Doug.  
3102', Br. lime 3173', Lans  
3191  
DST 3175-3233, opn 50 mins., rec  
10' mud 0#  
DST 3321-51, opn 50 mins., rec.  
5' mud 0#  
Arb. 3465'  
DST 3466-75, opn 1 hr., rec. 33'  
mud  
DST 3475-92, opn  $\frac{1}{2}$  hr., rec.  
10' mud,  
TD 3565' **ABANDONED**  
D&A

County Barton State Kansas

Sec. 19 (Blk. Twp.) 19 (Sur. Rge.) 13W Map No.

Operator Transit Corp.

Well No. 1 Farm L. Gunn

| Elev. | Location | SW | SW | NE |
|-------|----------|----|----|----|
|-------|----------|----|----|----|

0

FIRST REPORT

330 Ft. From S Line NE

330 Ft. From N Line Quarter

1st. Report OCT 29 1952

### Completion

Remarks Sun & Amerada support

Transit Corp. - Contr.

Spudding Date 10-25-52

Drig. Data Wildcat

Amby 759 8" @ 770 drlg. 965

J. G. MORTIMER