
Barton KANSAS

SECTION 19 TOWNSHIP 19 RANGE 13W

WELL NO. #1 Leroy

COMPANY CRA & Hulme

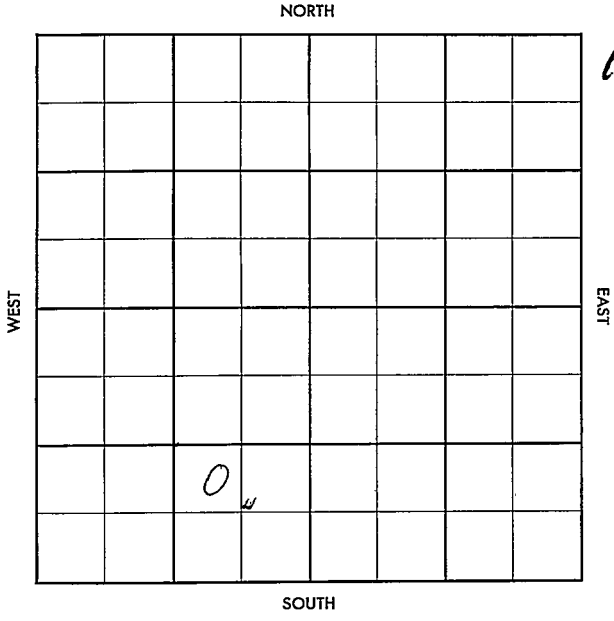

FORM 504-3 SUNRAY

Barton KANSAS

SEC.	TWP.	R.
19	19	13W

WELL NO. #1 Leroy FARM

COMPANY CRA & Hulme

CONTRACTOR

Semi-Wildcat


_____ FT. FROM N. LINE

_____ FT. FROM S. LINE

_____ FT. FROM E. LINE

_____ FT. FROM W. LINE

NW SE SW

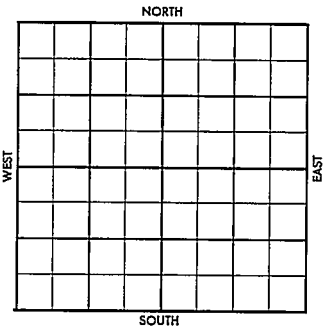

1956	ELEVATION 1862'	REPORT
5-23	RUR	
6-6	Comm. 5-22-56 8 5/8" @ 777 w/400 DST 3243-72 op 30 min. rec. 10' mud, BHP 0/20" DST 3466-72 op 30 min. rec. 7' mud, BHP 0/20" D&A H. 3086', Tr. 3100', Dg. 3115', ~~Bk~~ BL. 3186', L. 3198', cgl. 3420', S. 3464' TD 3500'	**ABANDONED**

FORM 504-5 SUNRAY

FORM 513 SUNRAY

County Barton Elev.

Sec. 19 Twp. 19S Rge. 13W

Company CRA & Hutme

Farm Name Leroy No. 1

TOPS	DEPTH	LOG	DATUM
Anh.			
Tp.			
H.			
Tr.			
Dg.			
Bl.			
L.			
K.C.			
B.K.C.			
Ce.			
C.			
M.			
M.			
K.			
Mz.			
Mo.			
V.			
S.			
S.			
A			
R.			
Pe.			
G.			
T.D.			

Loc. in Sec. NW SE SW

Geol.

Contr.

Pool Semi Wildcat



Date Comm. R U R

Co. Lse. No. Sec. T. R.

FORM 513 SUNRAY

County Barton Elev. 1962

Sec. 19 Twp. 19 Rge. 13W

Company CRA & Hulme

Farm Name Leroy No. 1

TOPS	DEPTH	LOG	DATUM
Anh.			
Tp.			
H.	3086		
Tr.	3100		
Dg.	3115		
Bl.	3186		
L.	3198		
K.C.			
B.K.C.			
Ce. Gl	3426		
G.			
M.			
M.			
K.			
Mz.			
Mo.			
V.			
S.			
S. ENES	3464		
A			
R.			
PE.			
G.			
TD	3500		

Loc. in Sec. NW SE SW

Geol.

Contr.

Pool Semi Wildcat

ABANDONED

Date Comm. JUN 6 1956

RUR MAY 29 '56 5-22-56 8 5/8

777/400 DST 3243-72 30" rec 10' Md DHP 0/20 Ø ahead

JUN 6 '56 DST 3466-72 (30) rec 7' M

BHP 0 (20) TD 3500

DST #

Co. Lse. No. Sec. T. R.