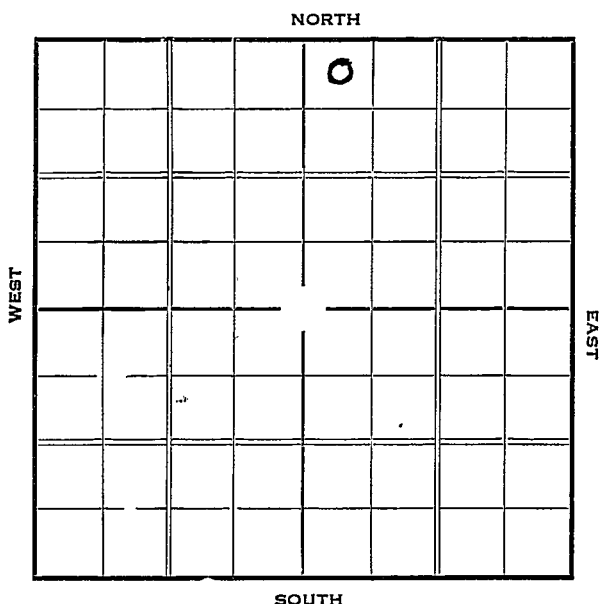


Section 19 Township 19 Range 16-WWell Number 1 - GreenawaltCompany Westgate-Greenland et al

1937

6/30 7" @ 3879'.

Sil. 3880'.

T.D. 4017: H.F.W.

P.B. 3777'.

~~CONDONED~~ ABANDONED

ABANDONED

Rush KANSASMap No. 81 Sec. 19 Twp. 19 R. 16 ^WWell No. 1 - GreenwaltWestgate - Greenland et al Company

Contractor

FIRST REPORT

SECTION PLAT

330 Ft. from N. Line Ft. from S. Line Ft. from E. Line330 Ft. from W. Line

		0	

Location Rig up

Drilling and Remarks:

Mod. in material

RECORD

Cased in., ft.Sand Gas Oil Total Depth

PRODUCTION

1st 24 hrs. Nat. 1st 24 hrs. after shot Gas Cu. Ft.Dry Hole Abandoned

Date

APR 23 1937

19

H. D. Hatfield Scout

Rush KANSAS

Map No. 21 Sec. 19 Twp. 19 R. 16 WWell No. 1 - GreenawaltWestgate - Greenland et al Company

Contractor

ABANDONED

330 Ft. from N. Line

_____ Ft. from S. Line

_____ Ft. from E. Line

330 Ft. from W. Line

SECTION PLAT

		0	

Location _____

Rig up _____

Drilling and Remarks:

PB. 3777

DKA

RECORD

Cased 7 in., 3879 ft.Sand 511-3880

Gas _____

Oil _____

Total Depth 4017 - H.F.W.

PRODUCTION

1st 24 hrs. Nat. _____

1st 24 hrs. after shot _____

Gas _____ Cu. Ft.

Dry Hole _____

Abandoned _____

Date

JUN 30 1937₁₉

H. D. Hatfield

Scout