


Section 2 Township 19 Range 12 W

Well No. # 2 De Garmo

Company J. C. Dozier

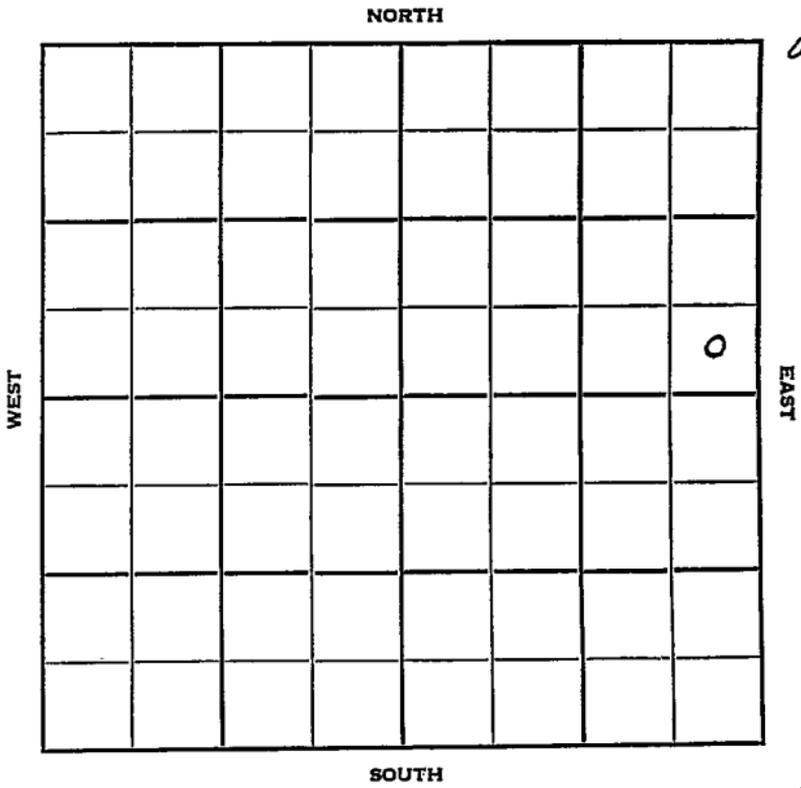

Barton

KANSAS

Sec. 2 Twp. 19 R. 12W

Well No. #2 DeGarmo Farm

J. C. Dozier Company

Contractor


_____ Ft. from N. Line

330' Ft. from S. Line

330' Ft. from E. Line

_____ Ft. from W. Line

SE SE NE

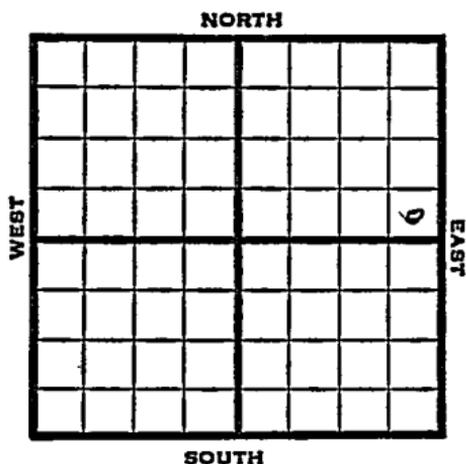

1951

Elv. 1828' REPORT

5/9 MIR

5/23

Spud 5-7-51
 D&A TD 3440
 8" @ 208'
 Top: 2738 Heeb. 3005
 Br Line 3116' Lans. 3133
 Cong. 3397 Arb. 3424'
 DST 3400-40 opn 1 hr. Rec. 10' mud
 TD 3440 D&A

ABANDONED

