


Section 2 Township 19 Range 12W

Well No. #1 Lewis

Company Aladdin Pet.

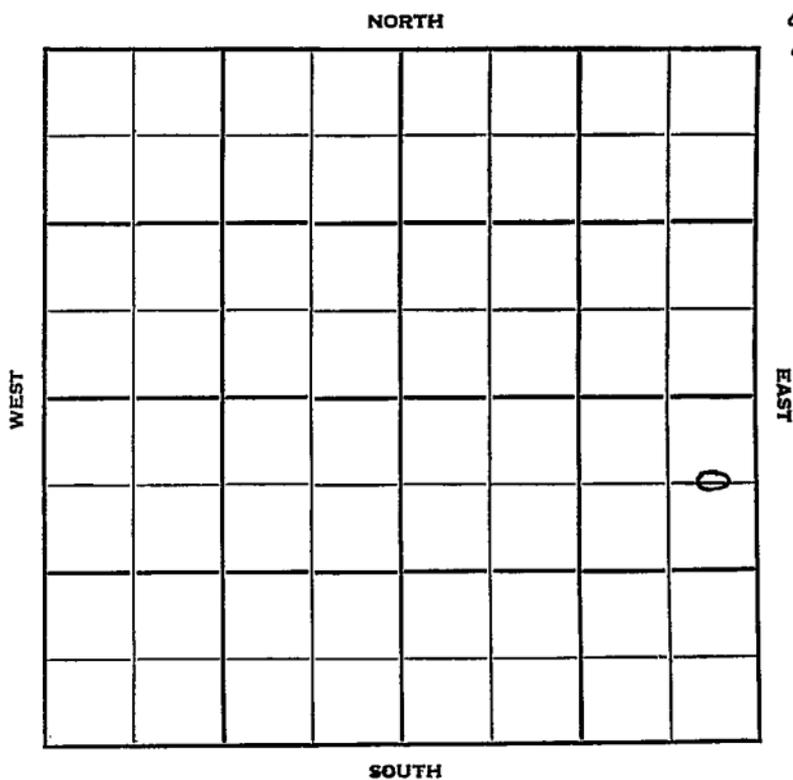

Sec. 2 Twp. 19 R. 12 W

Well No. #-1 Lewis Farm

Aladdin Pet. Company

Crowe Contractor


Cheyenne View

660 Ft. from N. Line

_____ Ft. from S. Line

330 Ft. from E. Line

_____ Ft. from W. Line

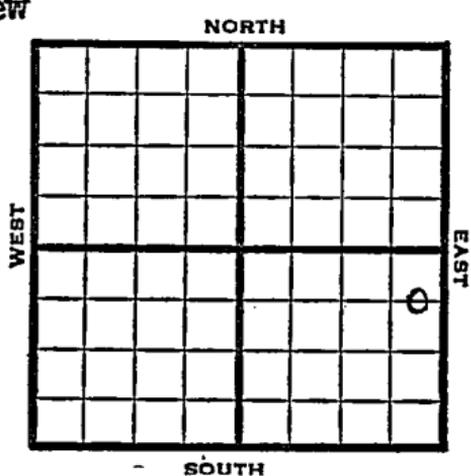

C E L N E S E

1952 Elev. 1830' REPORT

1/9 Spud 12-31-51
 8" @ 240'
 Br. L. 3111'
 Lans 3127'
 To DST

1/16 Spud 12-31-51
 D&A TD 3443'
 8" @ 240
 Br Li 3111 Lans. 3127
 DST 3126-3205 open 1 hr. rec. 8' mud
 DST 3247-3315 open 1 hr. rec. 120'
 gas 120' SO&GCM 50' VSO&GCM 50' mud
 & wtr. Cong. 3387 Arb. 3441-43 TD
 D&A

ABANDONED

County **Barton** State **Kansas**

Sec. **2** (Blk. **19**) (Sur. **12W**) (Twp. **19**) (Rge. **12W**) Map No.

Operator **Aladdin Pet.**

Well No. **1** Farm **Lewis**

Elev. **1830** Location **CEL NE SE**

FIRST REPORT

660 Ft. From **N** Line **SE**

330 Ft. From **E** Line **Quarter**

Ist. Report **JAN 9 1952**

Completion

Remarks

Crawe - Contr.

Spudding Date **12-31-51**

Drlg. Data **Cheyenne View**

8" @ 240' Br L 3111 Lans 3127 to DST

J. E. TYRA

County Barton State Kansas

Sec. 2 (Blk. 19) (Sur. Rge.) 12W Map No.

Operator Aladdin Pet.

Well No. 1 Farm Lewis

Elev. 1830 Location C E L N E S E

660 Ft. From N Line SE

330 Ft. From E Line Quarter

1st. Report

Completion JAN 16 1952

Remarks Cheyenne View Pool

Crowe Drlg. - Contr.

Spudding Date 12-31-51

Drlg. Data D & A TD 3443

8" @ 240 Br. lime 3111 Lens. 3127

DST 3126-3205 open 1 hr. Rec. 8' mud

DST 3247-3315 open 1 hr. Rec. 120' gas

120' so & gcm 50' vso & gcm 50' mud

& water Cong. 3387 Arb. 3441-43 TD

D & A