


Section 2 Township 19 Range 12 W

Well No. #1 Pomberlin

Company Muir & Giles

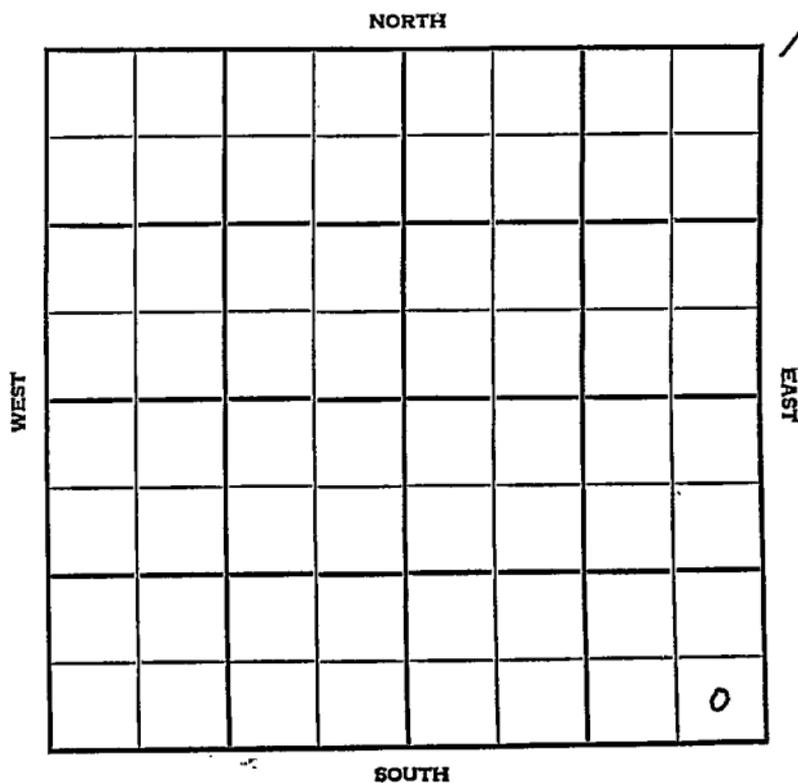

Barton

KANSAS

SEC. 2	TWP. 19	R. 12W
-----------	------------	-----------

WELL NO.

#1 Pomberlin

FARM

COMPANY

Muir & Giles

CONTRACTOR

L.C. Jackson

N. Cheyenne View

NORTH


_____ Ft. from N. Line

_____ Ft. from S. Line

_____ Ft. from E. Line

_____ Ft. from W. Line

SE SE SE

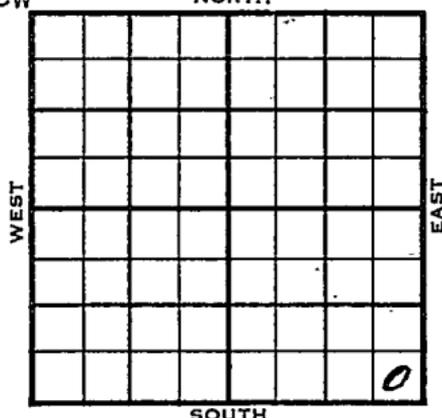

	ELEVATION	REPORT
1956	1813	

2-29

MIR

3-14

Comm. 2-28-56

8 5/8" @ 214/150

DST 3098-3180 op 45 min, rec. 30' mud,
0/15"DST 3232 -82 op 1 hr. rec. 450' msw,
580/30"DST 3388-93 op 1/2 hr. rec. 10' mud,
110/15"

D & A

H. 2975

Tr. 2994

Dg. 3007

Bl. 3089

L. 3107

C. 3364

A. 3387

TD 3407

ABANDONED

County Barton Elev. _____
 Sec. 2 Twp. 13N Rge. 12W
 Company Muir & Giles
 Farm Name Pomberlin No. 1

TOPS	DEPTH	LOG	DATUM
Anh.			
Tp.			
H.			
Tr.			
Dg.			
Bl.			
L.			
K.C.			
B.K.C.			
Ce.			
C.			
M.			
M.			
K.			
Mz.			
Mq.			
V.			
S.			
S.			
A.			
R.			
PE.			
G.			
T.D.			

Loc. in Sec. SE SE SE

Geol. _____
 Contr. L.C. Jackson

Pool N. Cheyenne View

FIRST REPORT		FEB 29 '56	

Date Comm. M I R

13

Co.
 No.
 Sec.
 T.
 R.

County Barton Elev. 7873
 Sec. 2 Twp. N 19 Rge. 12W
 Company Muir & Giles
 Farm Name Pomberlin No. 1

TOPS	DEPTH	LOG	DATUM
Anh.			
TP.			
H.	<u>2975</u>		
Tr.	<u>2954</u>		
Dg.	<u>3087</u>		
Bl.	<u>3089</u>		
L.	<u>3107</u>		<u>1294</u>
K.C.			
B.K.C.			
Ce.			
C.	<u>3364</u>		<u>1551</u>
M.			
M.			
K.			
Mz.			
Me.			
V.			
S.			
S.			
A.	<u>3387</u>		<u>1574</u>
R.			
PE.			
G.			
TR.	<u>3407</u>		

Loc. in Sec. SE SE SE
 Geol. _____
 Contr. _____
 L.C. Jackson
 Pool _____
 N. Cheyenne View

ABANDONED

Date Comm. 2-28-56 MAR 14 1956

8 5/8" @ 214/150 DST 3098-3180
open 45 min. rec. 30' mud 0/15"
DST 3232-82 open 1 hr. rec. 450' msw
580/30" DST 3388-93 open 1/2 hr.
rec. 10' mud 110/15"

D & A

Co.
 Lse.
 No.
 Sec.
 T.
 R.