


Section 2 Township 19 Range 11-W

Well Number #1-Birzer

Company Texas

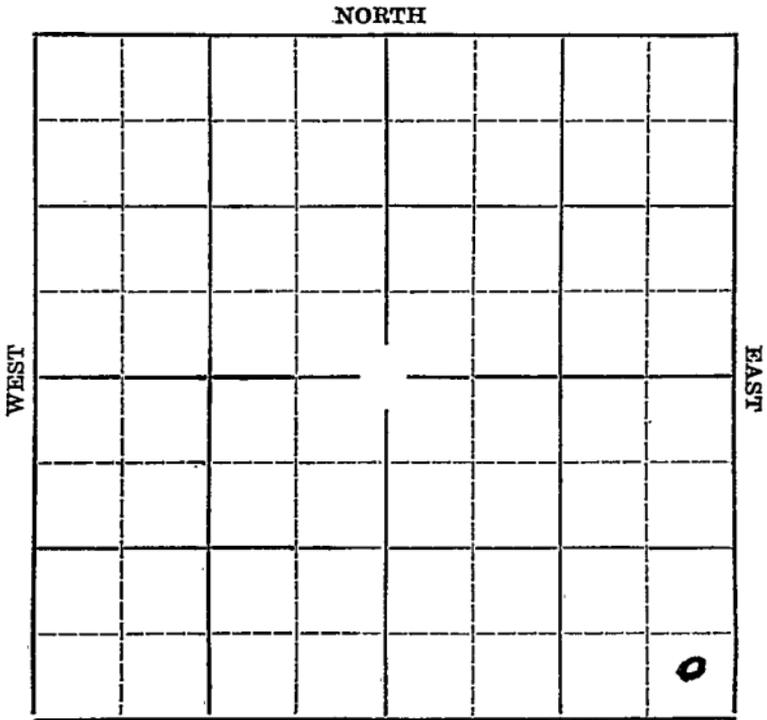

SOUTH


SPECIAL



Map No. **KANSAS** Sec. **2** Twp. **19** R. **11W**

Well No. **#1 Birzer** Farm _____
Texas Comapny. Company _____

_____ Ft. from N. Line
330' Ft. from S. Line
330' Ft. from E. Line
_____ Ft. from W. Line

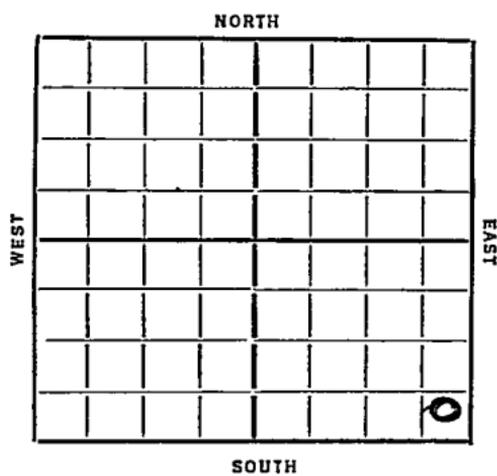

Elev. 1768

Date
1936
8/5
8/13
8/20
8/27
9/3
9/16

REPORT **SPECIAL**

Location
--
Rig.
12" @ 146'. Drlg. 550'.
Drlg. 2500'.
Conglomerate 3312
Siliceous 3379 T.D. 3390 HFW. D&A

ABANDONED

KANSAS

Map No. 46 Sec. 2 Twp. 19 R. 11W

Well No. 1 Bigger

Hayes Company

Contractor

SPECIAL

SECTION PLAT

			0

_____ Ft. from N. Line

330 Ft. from S. Line

330 Ft. from E. Line

_____ Ft. from W. Line

FIRST REPORT

Location ✓

Rig up _____

Drilling and Remarks:

RECORD

Cased _____ in., _____ ft.

Sand _____

Gas _____

Oil _____

Total Depth _____

PRODUCTION

1st 24 hrs. Nat. _____

1st 24 hrs. after shot _____

Gas _____ Cu. Ft.

Dry Hole _____

Abandoned _____

Date

AUG 5 1936

S. J. LEWIS Scout

KANSAS

Map No. 46 Sec. 2 Twp. 19 R. 11W

Well No. 1 Bigler

Hexas.

Company

Contractor

SECTION PLAT

_____ Ft. from N. Line

3.21 Ft. from S. Line

3.21 Ft. from E. Line

_____ Ft. from W. Line

ABANDONED

Location _____

Rig up _____

Drilling and Remarks:

Comp concrete
33/2

Sil 3379

HFW

J & A

RECORD

Cased _____ in., _____ ft.

Sand _____

Gas _____

Oil _____

Total Depth 3370

PRODUCTION

1st 24 hrs. Nat. _____

1st 24 hrs. after shot _____

Gas _____ Cu. Ft.

Dry Hole _____

Abandoned _____

Date

SEP 16 1936

S. J. LEWIS

Scout