

# KANSAS


Barton

FORM 51 5M 4-41 PETROL

Section 2 Township 19 Range 11-W

Well No. #2 Birzer

Company Texas

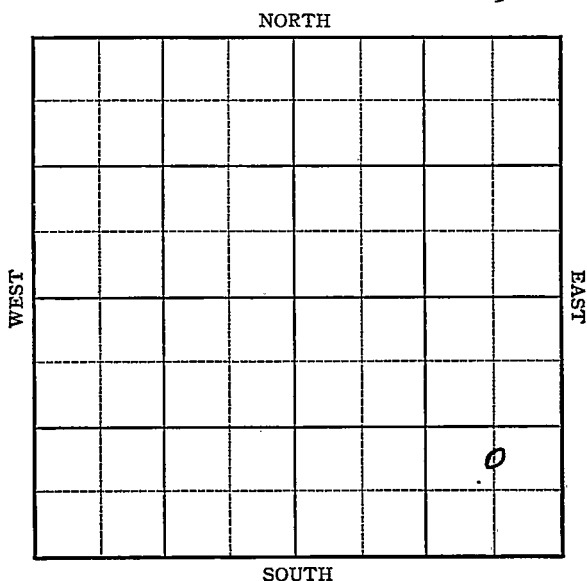

KANSAS


Barton

Sec. 2 Twp. 19 R. 11-WWell No. #2 Birzer FarmTexas Company

(Rick)

           Ft. from N. Line990 Ft. from S. Line660 Ft. from E. Line           Ft. from W. Line

Elev. 1763

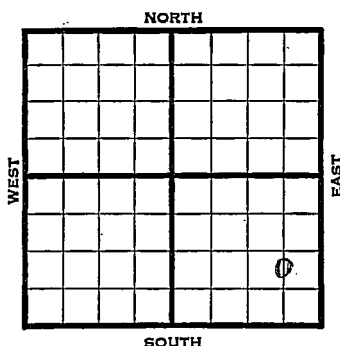

| 1941  | REPORT                         |
|-------|--------------------------------|
| 10/29 | Location                       |
| 11/6  | 10" - 200' Drlg. 275'          |
| 11/13 | Drlg. 2800'                    |
| 11/20 | Lans. 3020' Arb. 3360'         |
|       | 7" - 3267' T.D. 3374' 24 shots |
|       | 3093-3116' water. Shut down.   |
| 11/28 | 3000 acid. Swab water.         |
| 12/4  | P.B. to 3079'                  |
| 12/10 | Lans. 3020'                    |
|       | Arb. 3360'                     |
|       | 7" - 3267'                     |
|       | T.D. 3374'                     |
|       | 36 shots 3093½-3115½'          |
|       | 12 " 3120-24'                  |
|       | 24 " 3211-3196'                |
|       | 9500 acid.                     |
|       | Potential 37 bbls., pump.      |
|       | 36.8 Gravity                   |
|       | COMPLETED                      |

Map No. 11-46 Sec. 2 Twp. 19 R. 11WWell No. 2 BirzerTexas

Company

FIRST REPORT Contractor

C NL SE SE

## SECTION PLAT

|  |  |  |   |
|--|--|--|---|
|  |  |  |   |
|  |  |  |   |
|  |  |  |   |
|  |  |  | o |
|  |  |  |   |

       Ft. from N. Line990 Ft. from S. Line660 Ft. from E. Line       Ft. from W. Line

RICK POOL

Location XXRig up       

Drilling and Remarks:

## RECORD

Cased        in.,        ft.Sand       Gas       Oil       Total Depth       

## PRODUCTION

1st 24 hrs. Nat.       1st 24 hrs. after shot       Gas        Cu. Ft.Dry Hole       Abandoned       

Date

OCT 29 1941

19

S. J. LEWIS

Scout

Map No. 46 Sec. 2 Twp. 19 R. 11WWell No. 2 BirzerTexas CompanyCOMPLETED Contractor

C NL SE SE

SECTION PLAT

|  |  |  |   |
|--|--|--|---|
|  |  |  |   |
|  |  |  |   |
|  |  |  |   |
|  |  |  | o |

       Ft. from N. Line990 Ft. from S. Line660 Ft. from E. Line       Ft. from W. Line

RICK POOL

Location                     Rig up                     Drilling and Remarks:       Liam 3020Per 833607" 0326736 inch to 3093 1/2 - 3115 1/212 " 3120-2424 " 3211-31969500 acidPump 37 R & Y36 E Gr

## RECORD

Cased        in.        ft.Sand                     Gas                     Oil                     Total Depth 3374

## PRODUCTION

1st 24 hrs. Nat.                     1st 24 hrs. after shot                     Gas                      Cu. Ft.Dry Hole                     Abandoned                     

Date

DEC 10 1941

19

S. J. LEWIS

Scout