


Section 2 Township 19 Range 11W

Well No. #1 J. B. Birzer

Company Prime Drlg.

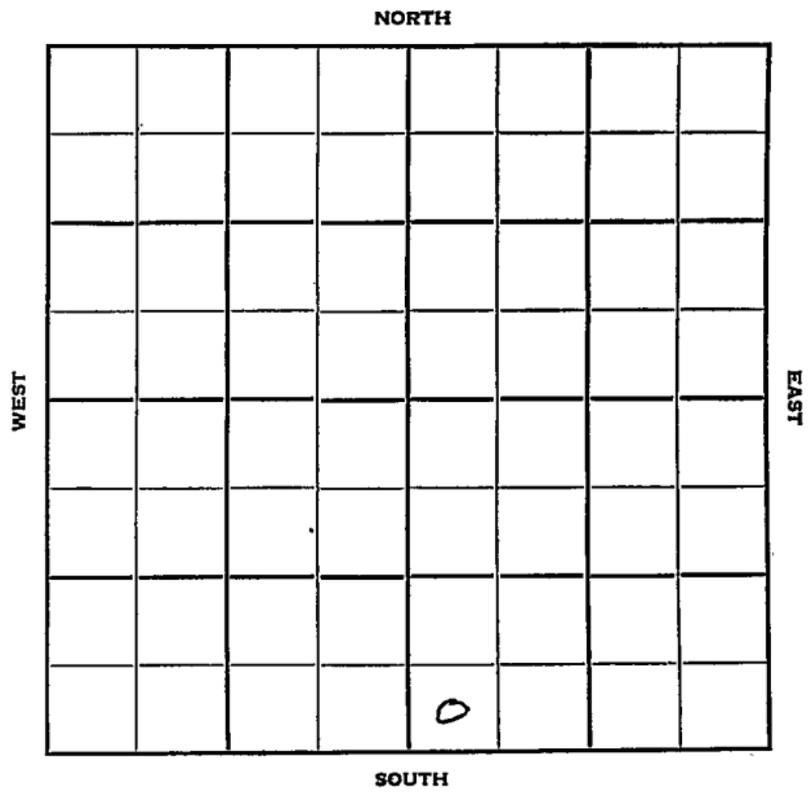

Sec. 2 Twp. 19 R. 11W

Well No. #1 J. B. Birzer Farm

Prime Drlg. Company

Prime Drlg. Contr. Contractor

Eberhardt Pool


 Ft. from N. Line

330' Ft. from S. Line

 Ft. from E. Line

330' Ft. from W. Line

SW SW SE

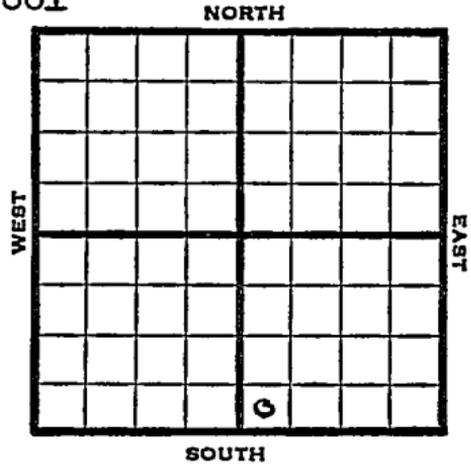

1950 Elev 1767 REPORT

10/11 Location

11/1 Spud 10-9-50

8" @ 248

Anhy 540

Heeb 2895

Br lime 3009

Lans 3029

SSO 3056-60

3120-30

DST 3055-3130 opn $\frac{1}{2}$ hr rec 190' gcm

Arb 3339

DST 3340-68 opn 1 hr rec 5' heavy oil
15' mud

DST 3348-90 TD

opn 1 hr rec 245' socm & wtr

TD 3390

Abandoned

ABANDONED

