

Barton

KANSAS

SECTION 2 TOWNSHIP 19S RANGE 11W

WELL NO. #1 Klepper


COMPANY Petroleum Inc.

NORTH

N/2 SE SW

WEST

EAST

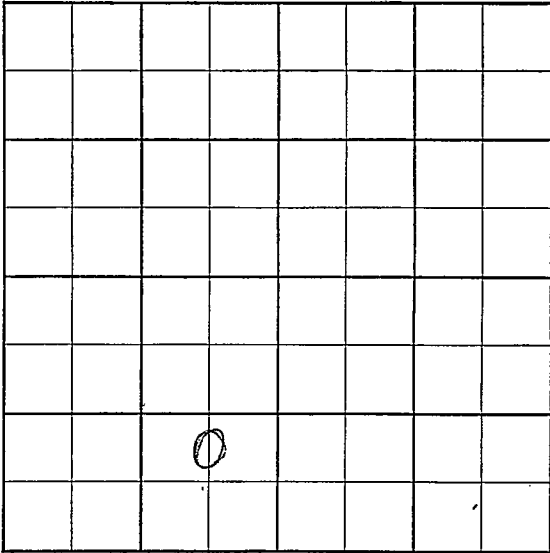

SOUTH

X X
 Twp. _____ Pool _____
 X X
 Co. _____ Facet _____

S-513-B


County Barton Elev. _____
 Sec. 2 Twp. 19 Rge. 11W
 Company Petroleum Inc.
 Farm Name Klepper No. 1

TOPS	DEPTH	LOG	DATUM
Anh.			
Tp.			
H.			
Tr.			
Dg.			
B.L.			
L.			
K.C.			
B.K.C.			
Ce.			
C.			
M.			
M.			
K.			
Mz.			
Mq.			
V.			
S.			
S.			
A.			
R.			
Pf.			
G.			
T.D.			

Loc. in Sec. _____
N/2 SE SW

Geol. _____
 Contr. _____
Garvey #?

Pool _____
Klepper

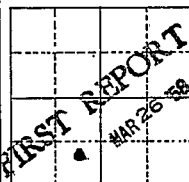

Date Comm. _____
to set 8" @ 300'

Co.

Lse.

No.

Sec.

T.

R.

Twp. X Pool /
 Co. X Facet /

S-513-B

County Barton Elev. 1775' to 1779'
 Sec. 2 Twp. 19 Rge. 11W
 Company Petroleum Inc.
 Farm Name Klepper No. 1

TOPS	DEPTH	LOG	DATUM
Anh.	647		
Tp.	2909		
H.			
Tr.			
Dg.			
B.L.	3024		
L.	3042		
K.C.			
B.K.C.			
Ce.			
C.			
M.			
M.			
K.			
Mz.			
Mq.			
V.			
S.			
S.			
A.	3370		
R.			
Pf.			
G.			
T.D.	3379		

Loc. in Sec. N/2 SE SW
 Geol.
 Contr. Garvey 8th
 Pool Klepper

ABANDONED
 MAY 7 '58

Date Comm. 4-1-58
 to set 8" @ 300' APR 2 '58 APR 9 '58 **DST**
2949-60 op/hr 34' MSW
BHP 1010 - 935/20" FPO
DST 3045-3105 op/hr 500'
gip 90' gemsw USSO 30
gemsw BHP 50/20 FPO
DST 3105 - 45 op 75" 60'
gip - 30' gemsw BHP 575/20
FPO - 95 DST 3175-3230

860" 150 gm VSSO BHP

360/30 FP 60-100 83310

APR 15 DST 3329-47 8/1 hr 10M

ALL P 2210 DST 3371-79 8/1 hr

190' g C O 150 fagg oil 6%OW 48/om

FPB BHP 1145/30-1025/45 No log

5" 3373/100 APR 23 '58 CW APR 30 '58

W 3379 TD \$ 1.3 B F PH 5 hrs 10%OW

250A \$ Ld 6 \$ 2 B F PH 16%OW

NT $\uparrow$ \$ 1.41 B F PH 36%OW WOO

MAY 7 '58 DD 3383 \$ 2.2 B F PH 54%

W 7 hrs PB 3320 8/3221-25

12/3191-97 Δ \$ 10 B F PH

D-6A