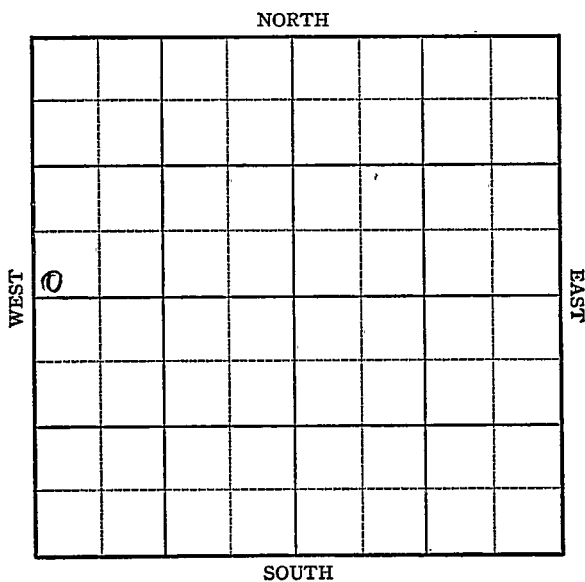



KANSAS

Section 2 Township 19 Range 11WWell No. # 1 MusenbergCompany Edourd Jonas
WILDCAT

Sec. 2 Twp. 19 R. 11-WWell No. #1 Musenberg FarmEdourd Jonas

Company

(Wildcat)

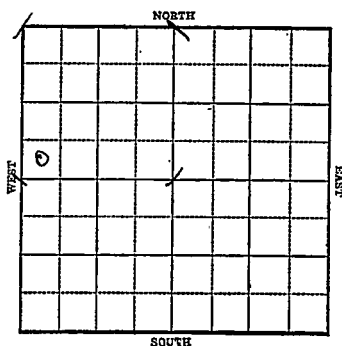 Ft. from N. Line330 Ft. from S. Line Ft. from E. Line330 Ft. from W. LineElev. 1777.

1942

R E P O R T

10/14 Location

10/21 "

10/28 Gable

11/4 "

11/11 12" @ 350'

Drlg. 550'

11/18 Drlg 1740

Anhy 567

10" @ 571

11/24 8" @ 2017'

Drlg. 2110'

12/2 Drlg. 2965

12/9 Lans 3086 water

Drlg. 3280 ~

12/16 7" @ 3090

BKC 3344

Booy 3380

TD 3390 SD.

12/22 Arb. ~~3480~~

TD 3485' SD

12/29 Arb. 3454 corrected

T.D. 3485'

No shows.

ABANDONED

Barton

KANSAS

Map No. 26 Sec. 2 Twp. 19 R. 11WWell No. 1 MusenbergEdourd Jonas CompanyFIRST REPORT Contractor

SW NW


Ft. from N. Line

330 Ft. from S. Line

Ft. from E. Line

330 Ft. from W. Line

SECTION PLAT

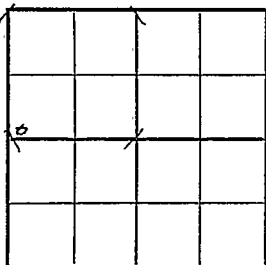

WILDCA T

Location XXX

Rig up

Drilling and Remarks:

RECORD

Cased _____ in., _____ ft.

Sand _____

Gas _____

Oil _____

Total Depth _____

PRODUCTION.

1st 24 hrs. Nat. _____

1st 24 hrs. after shot _____

Gas _____ Cu. Ft.

Dry Hole _____

Abandoned _____

Date

OCT 14 1942

19

S. J. LEWIS

Scout

KANSAS

Map No. 26 Sec. 2 Twp. 19 R. 11WWell No. 1 MusenbergEdourd Jonas CompanyABANDONED Contractor

SW NW

SECTION PLAT

o			

 Ft. from N. Line330 Ft. from S. Line Ft. from E. Line330 Ft. from W. Line

WILDCAT

Location Rig up

Drilling and Remarks:

*See 3454 @ directed**No shows*

RECORD

Cased in., ft.Sand Gas Oil Total Depth 3485

PRODUCTION

1st 24 hrs. Nat. 1st 24 hrs. after shot Gas Cu. Ft.Dry Hole Abandoned

Date

DEC 29 1942 19S. J. LEWIS Scout.