


Section 2 Township 19 Range 10W

Well No. 1 Hoescher

Company C. H. Weaver

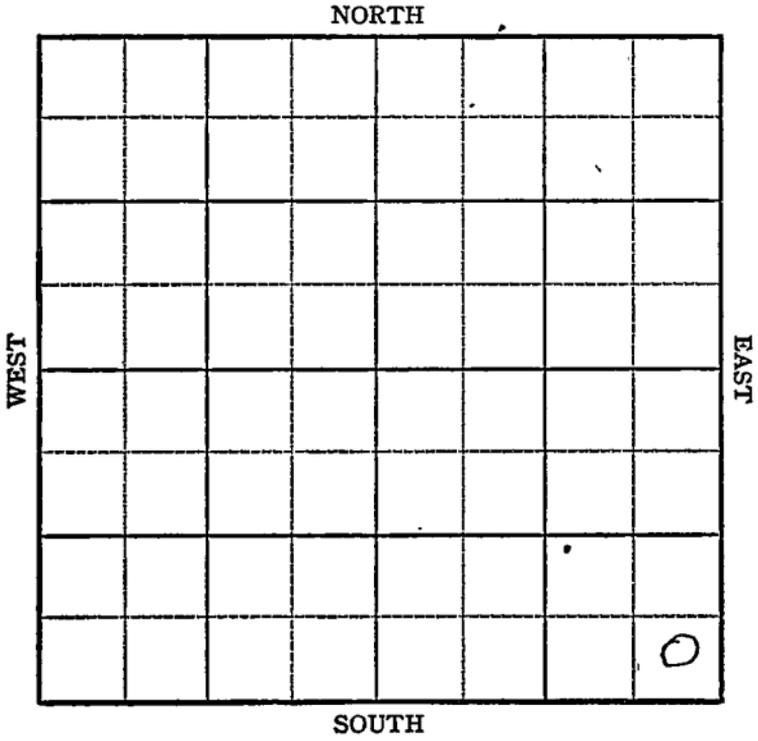

KANSAS

Rice ✓

Sec. 2 Twp. 19 R. 10W

Well No. #1 Hoescher Farm

C. H. Weaver Company

Silica Pool

Ft. from N. Line

330'


Ft. from S. Line

220'

Ft. from E. Line

Ft. from W. Line

SE/C

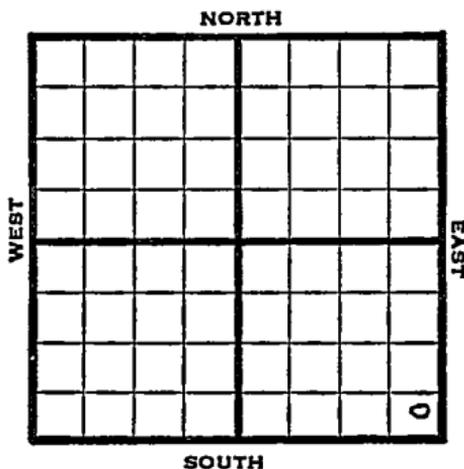

1948

Eli 1724'

REPORT

7/28

8" @ 215'  
Drlg. 1500'

8/4

SD

8/11

TD 3300'

8/18

Lansing 2937'  
Cong 3263'  
TD 3300' in Cong.  
Aband.

**ABANDONED**

Rice County Kansas State

Map No. \_\_\_\_\_ Sec. 2 Twp. 19 R. 10W

Well No. 1 Hoescher

C. H. Weaver Company

**FIRST REPORT**

Contractor

SE/C

**SECTION PLAT**

\_\_\_\_\_ Ft. from N. Line

330 Ft. from S. Line

220 Ft. from E. Line

\_\_\_\_\_ Ft. from W. Line

							o

Silica Pool

Remarks:

8" @ 215 drlg. 1500

Date JUL 28 1948

Scout S. J. LEWIS

Rice County Kansas State

Map No. 96 Sec. 2 Twp. 19 R. 10W

Well No. 1 Hoescher

C. H. Weaver Company

**ABANDONED**

Contractor

SE/C

E 11724  
SECTION PLAT

         Ft. from N. Line

330 Ft. from S. Line

220 Ft. from E. Line

         Ft. from W. Line

									0

Silica Pool

Remarks:

*Lane 2937*  
*Coag 8263*  
*YD 3300 in Coag*

Date  
AUG 18 1948

Scout S. J. LEWIS