

Map No. KANSAS Sec. 2 Twp. 19 R. 2

Well No. 2- Brady Farm

NORTH Derby & Shell



EAST


Drilling Remarks

Drilling Remarks

Cased _____ in. _____ ft.

Gas

Total Depth

Total Depth.....

1st 24 hrs. Nat. _____

1st 24 hrs. after shot_____

Gas _____ cu. ft. _____

Dry Hole_____

Abandoned

Map No. KANSAS Sec. 2 Twp. 19 R. 2^w

Well No. 2- Lady Farm.

~~Northwestern~~ Company

Derby & Shell


 Ft. from N. Line

660 Ft. from S. Line

660 Ft. from E. Line

 Ft. from W. Line

1931

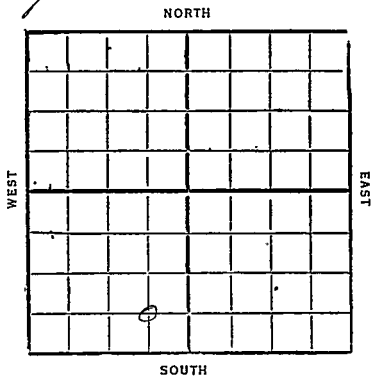

Date	REPORT
2/25	Loc
3/4	Drain up
3/11	Drlog 880'
3/18	" 1465
3/25	" 1950'
4/1	" 2350'
4/8	8"-2342
4/15	Drlog 2865'
4/15	Chat 2938
4/22	5 M gas at 2943
4/22	6"-2926
4/29	T.D. 2943 pull big pipe
5/6	T.D. 2943 Re-cement
5/6	T.D. 2943
5/13	Cementing Cave
5/13	Chat 2938-50
	T.D. 2950
	20,870,000 cu ft gas
	Comp.
1932	OWDD Done TD 2950.
9/14	Correction 2950 = 2942
	Gauge 16,688,000 gas
	drlog 2950

- 9/21- Deepened to
TD 2953 chat
No increase
- 9/30- TD 2962 fishing
- 10/5- TD 2965 wire UIR 5"
- 10/12- 5" liner at 2942
show oil 2972-75
dreg 2975
- 10/19- —
- 10/26- TD 2975 fish tools
- 11/2- deepened to
TD 2977
No test
- 11/9- Deepened to
TD 2977'
Gauge 21 AA gas
Comp

M. J. Brown 43

Map No. **KANSAS** Sec. 2 Twp. 19 R. 2 WWell No. 2 OakleyMoriaty State Company

Contractor

SECTION PLAT

Ft. from N. Line

660 Ft. from S. Line660 Ft. from E. Line

Ft. from W. Line

FIRST REPORTS

Location ✓

Rig up

Drilling and Remarks:

RECORD

Cased _____ in., _____ ft.

Sand _____

Gas _____

Oil _____

Total Depth _____

PRODUCTION

1st 24 hrs. Nat. _____

1st 24 hrs. after shot _____

Gas _____ Cu. Ft.

Dry Hole _____

Abandoned _____

Date

FEB 25 1931

S. J. LEWIS Scout

Handwritten scribbles and lines, possibly representing a signature or initials.

Returned	<i>TS</i>
Cards	<i>WWS</i>
Tracing	<i>WWS</i>
France Map	
Scarborough Map	<i>[Signature]</i>
Moody Map	
Scarborough Flat Book	
Moody Flat Book	

43 KANSAS

Map No. _____ Sec. 2 Twp. 19 R. 2 W

Well No. 2 Dadey

Merriarty et al Company

Contractor

COMPLETED

_____ Ft. from N. Line

660 Ft. from S. Line

660 Ft. from E. Line

_____ Ft. from W. Line

SECTION PLAT

	0		

Location _____

Rig up _____

Drilling and Remarks:

RECORD

Cased _____ in., _____ ft.

Sand Chat 2938-2950'

Gas _____

Oil _____

Total Depth 2950

PRODUCTION

1st 24 hrs. Nat. _____

1st 24 hrs. after shot _____

Gas 70,870,000 Cu. Ft.

Dry Hole _____

Abandoned _____

Date

MAY 13 1931

192

CHAS. L. SHERWOOD

Scout

Private
copy

Returned	<i>RP</i>
Cards	
Tracing	<i>CPH</i>
France Map	<i>X</i>
Scarborough Map	<i>X</i>
Moody Map	<i>X</i>
Scarborough Flat Book	
Moody Plot Book	

McPherson

W

43 KANSAS

Map No. _____ Sec. 2 Twp. 19 R. 2Well No. 2 DadeyDerby & Shell Company

Contractor

FIRST REPORTS

SECTION PLAT

_____ Ft. from N. Line

660 Ft. from S. Line660 Ft. from E. Line

_____ Ft. from W. Line

Previously carried
as Moriarty et al

	"		"
	OWD		

Location _____

Rig up _____

Drilling and Remarks:

Old T.S. 2950 in Chat
Gauge 18,688,000

2950 = 2942

By 2950

RECORD

Cased _____ in., _____ ft.

Sand _____

Gas _____

Oil _____

Total Depth _____

PRODUCTION

1st 24 hrs. Nat. _____

1st 24 hrs. after shot _____

Gas _____ Cu. Ft.

Dry Hole _____

Abandoned _____

Date

SEP 1 4 1932 CHAS. L. SHERWOOD
Scout

[Handwritten scribbles and lines]

Returned	<i>[initials]</i>
Cards	<i>[initials]</i>
Tracing	<i>[initials]</i>
France Map	<i>[initials]</i>
Scarborough Map	<i>[initials]</i>
Moody Map	<i>[initials]</i>
Scarborough Plat Book	<i>[initials]</i>
Moody Plat Book	<i>[initials]</i>

43 KANSAS

Map No. _____ Sec. 2 Twp. 19 R. 2 W

Well No. 2 Daley

Derby & Sheel Company

Contractor

COMPLETED

_____ Ft. from N. Line

660 Ft. from S. Line

660 Ft. from E. Line

_____ Ft. from W. Line

SECTION PLAT

Location _____

Rig up _____

Drilling and Remarks:

RECORD

Cased _____ ft.
 Sand Top of Hat 2938
 Gas _____
 Oil _____
 Total Depth 2977

PRODUCTION

1st 24 hrs. Nat. _____
 1st 24 hrs. after shot _____
 Gas 21 m Cu. Ft.
 Dry Hole _____
 Abandoned _____

Date

NOV 9 1932 CHAS. L SHERWOOD

192

Scout

Returned _____
Cards _____
Tracing _____
France Map _____
Scarborough Map _____
Moody Map _____
Scarborough Book _____
Moody Port Book _____