
KANSAS Barton

FORM 51 5M PETROL

Section 2 Township 19 Range 15W

Well No. 3 Schwartz

Company Black-Marshall

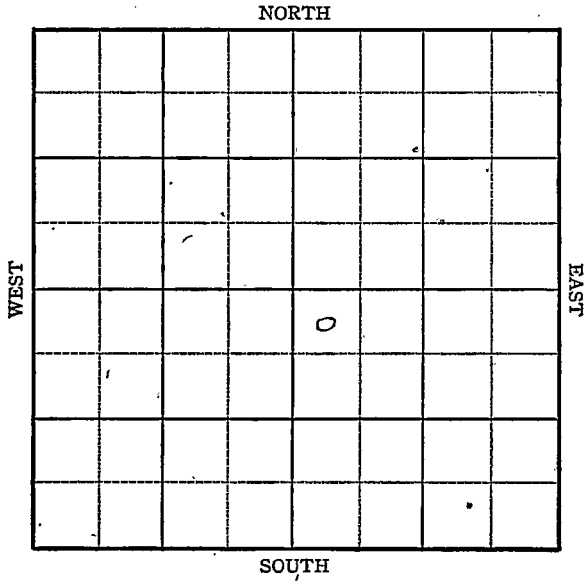

70

FORM 252-A
5M 8-45 PETROL

KANSAS Barton

Sec. 2 Twp. 19 R. 15-W

Well No. #3 Schwartz Farm

Black-Marshall Company


330 Ft. from N. Line

Ft. from S. Line

Ft. from E. Line

330 Ft. from W. Line

NW SE

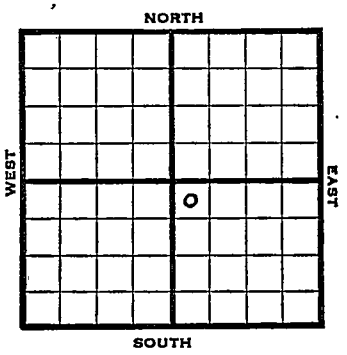

1945	Elev. 1966 REPORT
10/3	RUR
10/3	
10/10	8" @ 952
	Anhy. 937
	WOC
10/17	Lans 3295
	Drlg. 3430
10/24	Reagan 3570-3573
	TD 3573
	5" @ 3571 RUST
10/31	" " "
11/7	TD 3595
	1060' oil in 12 hrs.
11/14	" " " "
11/21	" " " "
11/28	Arb. 3569
	Reagan 3591
	5" @ 3571
	TD 3593
	Pump 30 Pot.
	Grav. 36.0

COMPLETED

FORM 26 200 BKS 1-44 PETROL

KANSAS Kansas Pool Name Mertens

Map No. 82 Sec. 2 Twp. 19 R. 15W

Well No. 3 Schwartz

Black-Marshall Company

FIRST REPORT Contractor

NW SE

330 Ft. from N. Line


Ft. from S. Line

Ft. from E. Line

330 Ft. from W. Line

Barton County

SECTION PLAT

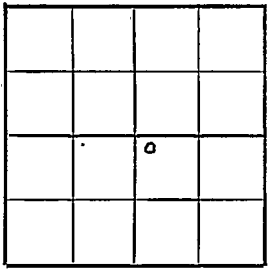

Location

Rig up

Drilling and Remarks:
RUR

RECORD

Cased in., ft.

Sand

Gas

Oil

Total Depth

PRODUCTION

1st 24 hrs. Nat.

1st 24 hrs. after shot

Gas Cu. Ft.

Dry Hole

Abandoned

Date

OCT 3 1945 19

S. J. LEWIS Scout

FORM 26 200 BKS 1-44 PETROL

KANSAS Kansas Pool Name Mertens

Map No. 82 Sec. 2 Twp. 19 R. 15W

Well No. 3 Schwartz


Black- Marshall Company

COMPLETED Contractor

NW SE

E.L. 1966

SECTION PLAT

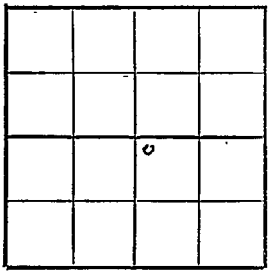

330 Ft. from N. Line

Ft. from S. Line

Ft. from E. Line

330 Ft. from W. Line

Barton County

Location

Rig up

Drilling and Remarks:

Cel 3569

Reag on 3581

5" 3587

Pump 80 BO

86° Gr

RECORD

Cased in., ft.

Sand

Gas

Oil

Total Depth 3529

PRODUCTION

1st 24 hrs. Nat.

1st 24 hrs. after shot

Gas Cu. Ft.

Dry Hole

Abandoned

Date

NOV 28 1945 19

S. J. LEWIS Scout