FORM 51 10M 7-48 PETROL


KANSAS Barton

Section 2 Township 19 Range 15W

Well No. 2 Bahr

Company Phil-Han

Mertens Pool

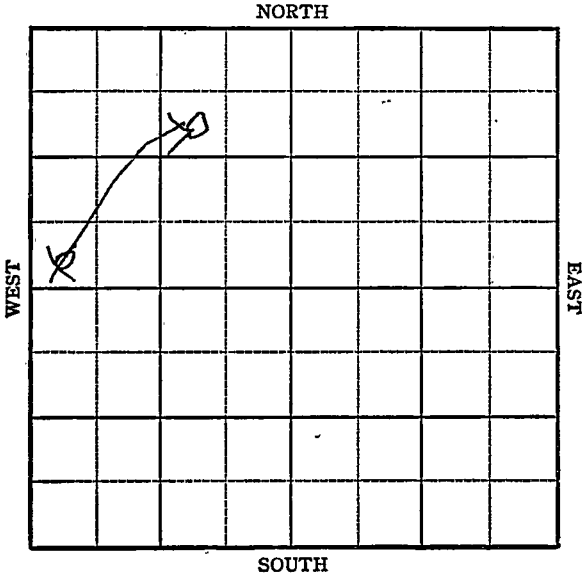

FORM 252-A
5M 10-48 PETROL

Barton

Sec. 2 KANSAS Twp. 19 R. 15W ✓

Well No. #2 Bahr Farm

Phil-Han Company

Mertens Pool


990' Ft. from N. Line

~~330'~~ Ft. from S. Line

990' Ft. from E. Line

~~330'~~ Ft. from W. Line

SW ~~NW~~ NE NW

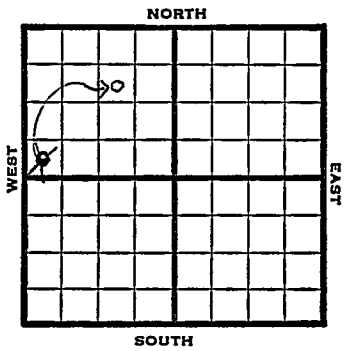

1948	· Eli 1982' REPORT
10/27	8" @ 900'
11/3	Drlg. 3090'
11/10	Lansing 3289' Arbuckle 3577' TD 3597' Reagan 3593' 5" @ 3591'
11/16	"
11/23	"
11/30	"
12/8	"
12/15	"
12/22	TD 3598' 1000' oil 6 hrs.
12/29	"
1/5	"
1/12	"
1/19	TD 3598' Reagan 3593' 5"@ 3591' Pump 50 oil Pot 36° Gr. Comp. **COMPLETED**

Form 26 200 Bks. 9-48 Petrol

Kansas

Mertens Pool

Map No. ____ Sec. 2 Twp. 19 R. 15W


Well No. 2 Bahr

Phil-Han Company

FIRST REPORT Contractor

SW NW

SECTION PLAT

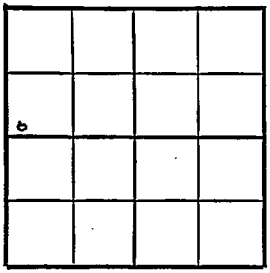

____ Ft. from N. Line

330 Ft. from S. Line

____ Ft. from E. Line

330 Ft. from W. Line

Barton County

Location

Rig up

Drilling and Remarks:

8" @ 900

RECORD

Cased ____ in., ____ ft.

Sand

Gas

Oil

Total Depth

PRODUCTION

1st 24 hrs. Nat.

1st 24 hrs. after shot

Gas ____ Cu. Ft.

Dry Hole

Abandoned

Date

OCT 27 1948 19

S. J. LEWIS Scout

Form 26 200 Bks. 9-48 Petrol

Kansas

Mertens Pool

Map No. 82 Sec. 2 Twp. 19 R. 15W

Well No. 2 Bahr

Phil-Han Company

CORRECTION Contractor

SW NE NW


990 Ft. from N. Line

Ft. from S. Line

990 Ft. from E. Line

Ft. from W. Line

SECTION PLAT

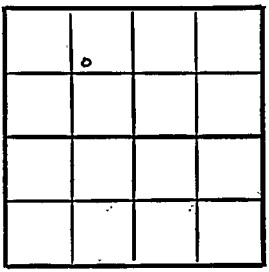

Barton County

Location

Rig up

Drilling and Remarks:

Reported
SW NW

RECORD

Cased in., ft.

Sand

Gas

Oil

Total Depth

PRODUCTION

1st 24 hrs. Nat.

1st 24 hrs. after shot

Gas Cu. Ft.

Dry Hole

Abandoned

Date

NOV 3 1948 19 S. J. LEWIS Scout

Form 26 200 Bks. 9-48 Petrol

Mertens Pool

Kansas

Map No. 82 Sec. 2 Twp. 19 R. 15W

Well No. 2 Bahr


Phil-Han Company

COMPLETE Contractor

SW NE NW

E1,982

SECTION PLAT

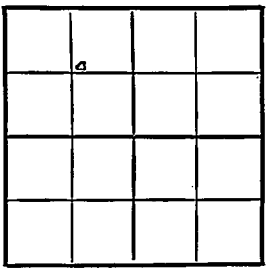

990 Ft. from N. Line

____ Ft. from S. Line

990 Ft. from E. Line

____ Ft. from W. Line

Barton County

Location

Rig up

Drilling and Remarks:

Reagan 3598

5" to 3591

Pump 50 oil BH

36°/Gr

RECORD

Cased ____ in., ____ ft.

Sand

Gas

Oil ✓

Total Depth 3598'

PRODUCTION

1st 24 hrs. Nat.

1st 24 hrs. after shot

Gas ____ Cu. Ft.

Dry Hole

Abandoned

Date

JAN 19 1949 19

S. J. LEWIS Scout