


Section 2 Township 19 Range 15W

Well No. 2 Schwartz

Company Black-Marshall

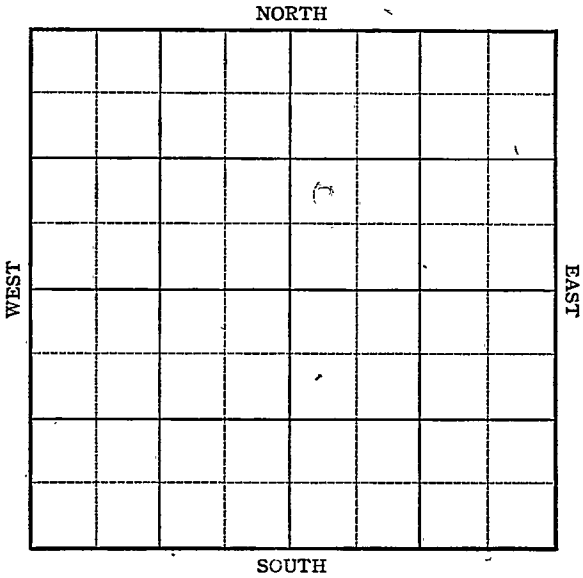

Sec. 2 Twp. 19 R. 15-W


Well No. #2 Schwartz Farm
Black-Marshall Company

 Ft. from N. Line

990 Ft. from S. Line

 Ft. from E. Line

330 Ft. from W. Line

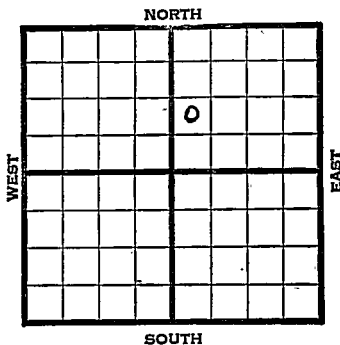

NW SWNE Elev. 1978

1945

REPORT

8/1	SH
8/8	8" @ 150
	Drlg. 2580
8/15	Lans 3301
	Reagan 3595
	TD 3598'
	Run 5"
8/22	" "
8/29	5" @ 3595
	Swab 55 oil
9/5	" "
9/12	Reagan 3595
	5" @ 3595
	TD 3598
	Pump 144 Pot.
	Grav. 36.3

COMPLETED

