


Section 2 Township 19 Range 15

Well No. 1 H. P. Schwartz

Company Black-Marshall et al

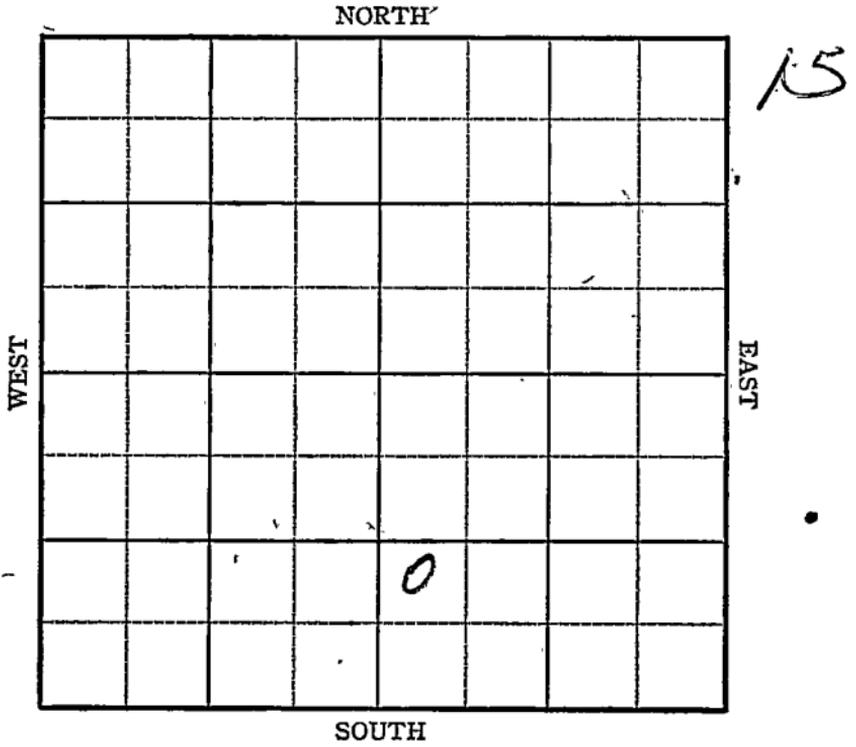

KANSAS

Barton

Sec. 2

Twp. 19

R.

15^W

Well No. 1 H. P. Schwartz Farm

Black-Marshall etal Company

Mertens

_____ Ft. from N. Line


990

_____ Ft. from S. Line

_____ Ft. from E. Line

330

_____ Ft. from W. Line

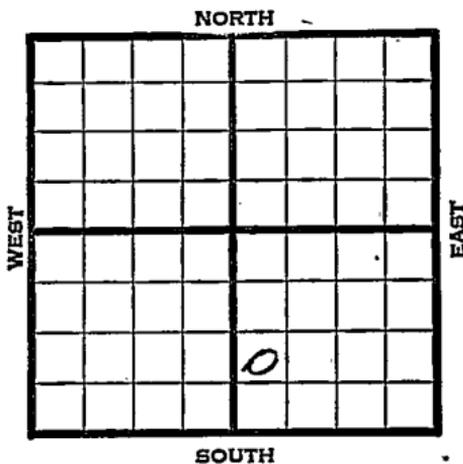

NW SW SE Elev. 1970

1945

REPORT

6/27

Location

7/3

Drlg. 600'

7/11

Anhy 940

8" @ 955

Drlg. 2950'

8/19

Drlg. 3590'

7/26

Lans 3289

Reagan 3615

TD 3626

5" @ 3615

800' wtr. SSO

8/8

Reagan 3615

5" @ 3615'

T.D. 3627'

P.B. 3624'

Pump 75 oil plus 25 water

Pot.

Gravity 36

COMPLETED

Kansas Pool Name MertensMap No. 82 Sec. 2 Twp. 19 R. 15WWell No. 1 H. P. SchwartzBlack-Marshall et al Company

FIRST REPORT

Contractor

NW SW SE

SECTION PLAT

 Ft. from N. Line990

Ft. from S. Line

 Ft. from E. Line330

Ft. from W. Line

		o	

Barton CountyLocation XRig up

Drilling and Remarks:

RECORD

Cased in., ft.Sand Gas Oil Total Depth

PRODUCTION

1st 24 hrs. Nat. 1st 24 hrs. after shot Gas Cu. Ft.Dry Hole Abandoned

Date

JUN 27 1945 19S. J. LEWIS Scout

