


Section 2 Township 19 Range 13 W

Well No. # 1 Flanders

Company Murfin & Autry

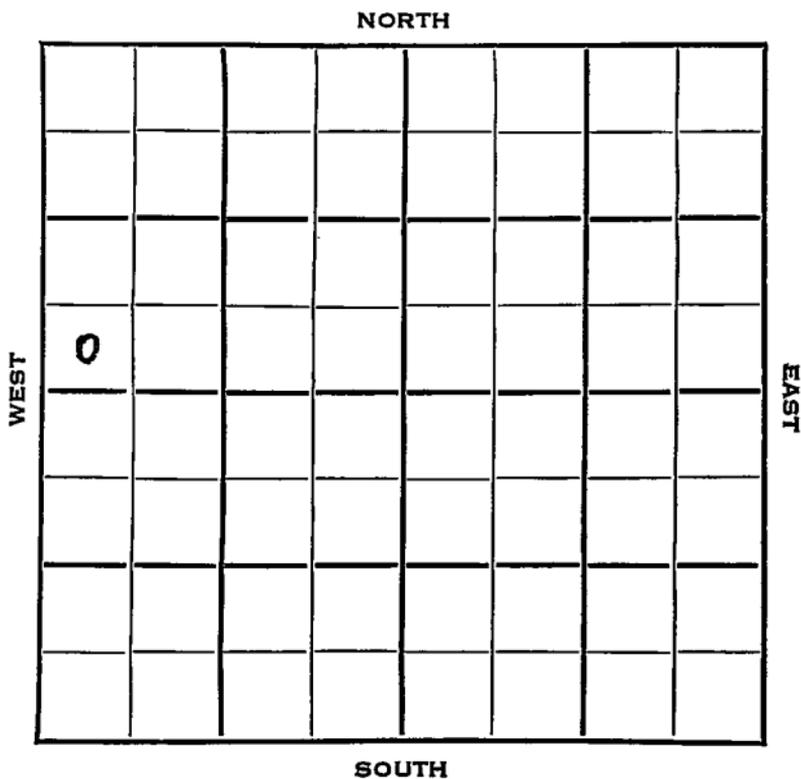

Barton

KANSAS


SEC. 2	TWP. 19	R. 13 W
-----------	------------	------------

WELL NO. # 1 Flanders FARM

COMPANY Murfin & Autry

CONTRACTOR Murfin Drlg.
Wildcat

_____ Ft. from N. Line
330 _____ Ft. from S. Line
_____ Ft. from E. Line
330 _____ Ft. from W. Line

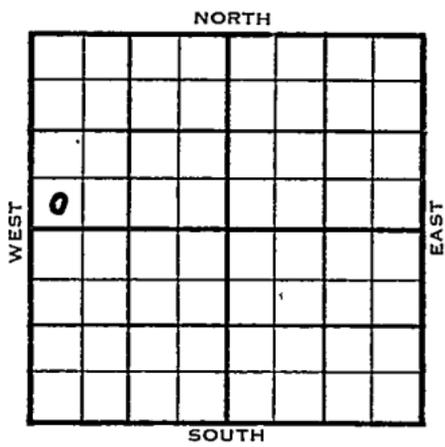

SW SW NW

Magnolia DHM

	ELEVATION	REPORT
1953	Elev. 1848'	

10/14 Spud 10-6-53
8" @ 200 Anhy 728
Drlg. 2926'

10/21 Spud 10-6-53
D & A TD 3420' 8" @ 200
Anhy 728 Heeb 3023 Br lime 3120
Lans 3122 B KC 3322 Arb. 3372
DST 3375-80 open 3/4 hr. rec 4' mud
O#
DST 3379-88 open 1/2 hr rec 8' mud O#
TD 3420' D & A

ABANDONED

