

Barton KANSAS

Section 2 Township 19 Range 13 W

Well No. # 1 Flanders

Company Ben Brack Oil

NORTH

WEST

EAST

SOUTH

Barton

KANSAS

Sec. 2 Twp. 19 R. 13W

Well No. #1 Flanders Farm

Ben Brack Oil Company

Brack-Contr. Contractor

Wildcat


330' Ft. from N. Line

_____ Ft. from S. Line

_____ Ft. from E. Line

330' Ft. from W. Line

NW NW NW

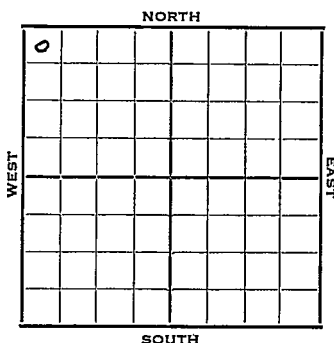

1952 Elev. 1820' REPORT

4/23 Spud 4-17-52
8" @ 178
Anhy 709
Drlg. 2129'

4/30 Spud 4-17-52
D&A TD 3385' 8" @ 178'
Anhy 709 - Br Li 3100 Lans. 3112
Cong. 3346 Arb. 3359
DST 3358-65 open 45 min. rec. 10' mud
DST 3365-85 open 20 min. rec. 190' sw
TD 3385' D&A

ABANDONED

County Barton State Kansas
 Sec. 2 (Blk.) 19 (Sur.) 13W Map No.

Operator Ben Brack Oil
 Well No. 1 Farm Flanders
 Elev. 1820 Location NW NW NW

0					

FIRST REPORT

330 Ft. From N Line NW
 330 Ft. From W Line Quarter

1st. Report APR 23 1952

Completion

Remarks


Brack - Contr.

Spudding Date 4-17-52

Drlg. Data Wildcat
8" @ 178 Anhy 709 drlg. 2129

J. G. McGEHEE

County Barton State Kansas
 Sec. 2 (Blk. 19 (Sur. 13W Map No.
 (Twp.) (Rge.)
 Operator Ben Brack Oil
 Well No. 1 Farm Flanders
 Elev. 1820 Location NW NW NW

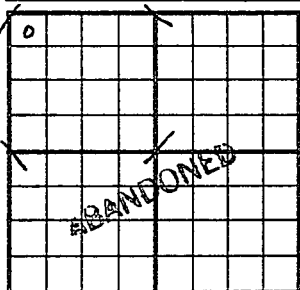

330 Ft. From N Line NW
330 Ft. From W Line Quarter
 1st. Report
 Completion APR 30 1952
 Remarks Wildcat
Brack - Contr.
 Spudding Date 4-17-52

Drlg. Data D & A TD 3385
8" @ 178 Anhy 709 Br. lime 3100
Lans. 3112 Cong. 3346 Arb. 3359
DST 3358-65 open 45 min. Rec. 10' mud
DST 3365-85 open 20 min. Rec. 190' sw
TD 3385

D & A

J. G. McGEHEE