

Section 20 Township 19 Range 11WWell No. #1 Kowalsky "B"Company Alpine Oil & Royalty

NORTH

			0				

WEST

EAST

SOUTH

Barton

KANSAS

Sec. 20 Twp. 19 R. 11W

Well No. #1 Kowalsky "B" Farm

Alpine Oil & Royalty Company

Prairie View Pool Contractor

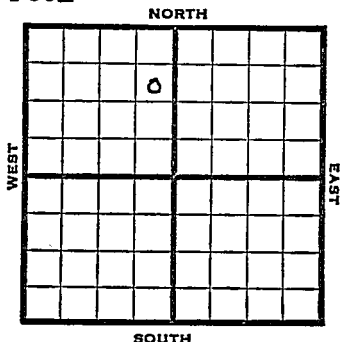
990' Ft. from N. Line

Ft. from S. Line

330' Ft. from E. Line

Ft. from W. Line

SE NE NW



1950

Elev. 1790' REPORT

11/29

Spud 11-22-50

8" @ 230'

Drlg. 2150'

3/21

Spud 11-22-50

D&A TD 3388

8" @ 230

Anhy 585' Heeb. 2951

Br Lime 3068' Lans. 3087

DST 3253-3330 opn 1 hr

Rec. 360' gas 50' ocm

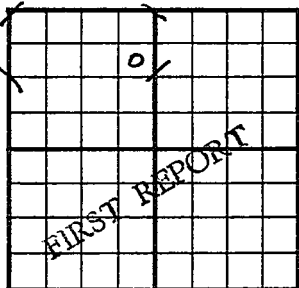
Cong. 3354 Arb. 3380-88

5" @ 3387 24/3309-15 24/3285-92

500 A S/3 boph 1000 A water

D&A

ABANDONED

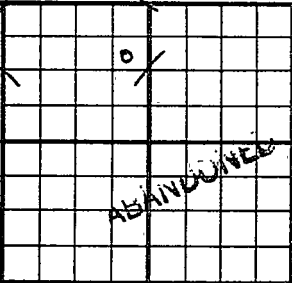
County Barton State KansasSec. 20 (^{Blk.}
Twp.) 19 (^{Sur.}
Rge.) 11W Map No.Operator Alpine Oil & RoyaltyWell No. 1 Farm Kowalsky "B"Elev. 1790 Location SE NE NW990 Ft. From N Line NW530 Ft. From E Line Quarter1st. Report NOV 29 1950

Completion _____

Remarks _____

Spudding Date 11-22-50Drlg. Data Prairie View Pool8" @ 230 drlg. 2150

J. E. TYRA

County	Barton		State	Kansas	
Sec.	20	(Blk.) Twp.)	19	(Sur.) Rge.)	11W Map No.
Operator	Alpine Oil & Royalty				
Well No.	1	Farm	Kowalsky "B"		
Elev.	1790	Location	SE NE NW		
			990 Ft. From N Line NW		
			330 Ft. From E Line Quarter		
			1st. Report		
			Completion MAR 21 1951		
			Remarks Prairie View Pool		
			Spudding Date 11-22-50		

Drlg. Data D & A TD 3388
 8" @ 230 Anhy 585 Heeb. 2951
 Br. lime 3068 Lans. 3087 DST 3253-3330
 open 1 hr. Rec. 360' gas 50' ocm
 Cong. 3354 Arb. 3380-88 5" @ 3387
 24/ 3309-15 24/ 3285-92 500 A
 S/ 3 boph 1000 A water

D & A

J. E. TYRA