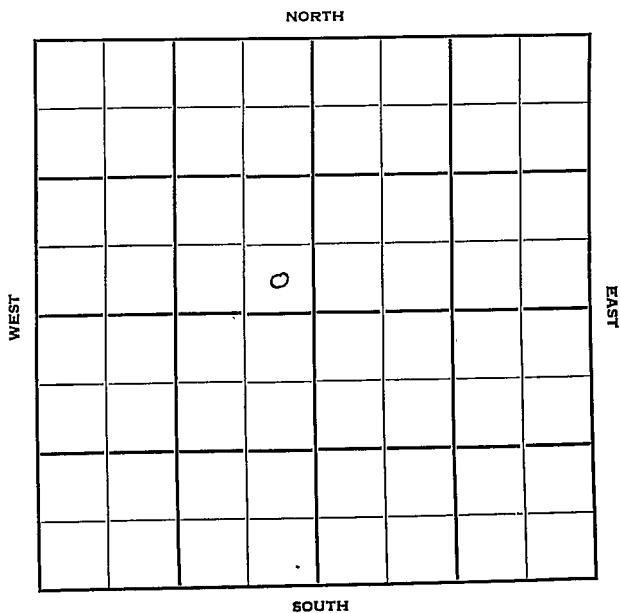


Section 20 Township 19 Range 11-WWell No. #1 KowalskyCompany Alpine Oil & Royalty

Barton

KANSAS

Sec. 20 Twp. 19 R. 11W

Well No. #1 Kowalsky Farm

Alpine Oil & Royalty Company

Quaker Drlg. Contractor

Lanterman


Ft. from N. Line

330' Ft. from S. Line

330' Ft. from E. Line

Ft. from W. Line

SE SE NW

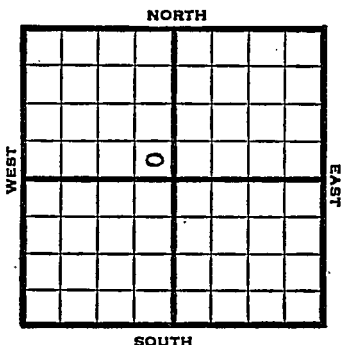

Oil Well

1950

Elev 1787

REPORT

6/28

Spud 6-23-50
8-5/8" @ 260'
Anhy. 572'
Drlg. 2795'

9/13

8 5/8" @ 260

Anhy 572

Br lime 3059

Lans 3078

DST 3080-3118 op 1 hr rec 360' free oil
120' hocm

Cong 3347

Arb 3371-76

5" @ 3373

108/3080-3116

S/3 boph 4 hr 500 A F/100 boph

Comp 361 bopd

TD 3376

Completed

COMPLETED

Map No. _____ Sec. 20 Twp. 19 R. 11WWell No. 1 Kowalsky

_____ Alpine Oil & Royalty Company

_____ Quaker Drl. Contractor

SE SE NW

_____ Ft. from N. Line

330 Ft. from S. Line330 Ft. from E. Line

_____ Ft. from W. Line

SECTION PLAT



Barton County

Location _____

Rig up _____

Drilling and Remarks:

Spud 6-23-50

8 5/8" C260

Anhy 572

drlg. 2795

RECORD

Cased _____ in., _____ ft.

Sand _____

Gas _____

Oil _____

Total Depth _____

PRODUCTION

1st 24 hrs. Nat. _____

1st 24 hrs. after shot _____

Gas _____ Cu. Ft.


Dry Hole _____

Abandoned _____

Date

JUN 28 1950 19 J. E. TVRA Scout

County Barton State Kansas
 Sec. 20 (^{Blk.}Twp.) 19 (^{Sur.}Rge.) 11W Map No. _____
 Operator Alpine Oil & Royalty
 Well No. 1 Farm Kowalsky
 Elev. 1787 Location SE SE NW

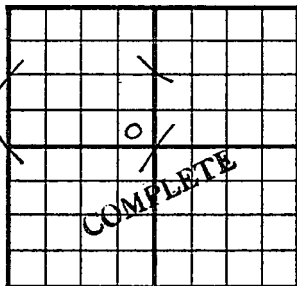

330 Ft. From S Line NW
330 Ft. From E Line Quarter

1st. Report

Completion SEP 13 1950

Remarks

Lanterman Pool

Spudding Date 6-23-50

Drlg. Data Oil well TD 3376
8 5/8" @ 260 Anhy 572 Br. lime 3059
Lans. 3078 DST 3080-3118 open 1 hr.
Rec. 360' free oil 120' hocm Cong. 3347
Arb. 3371-76 5" @ 3373 108/ 3080-3116
8/ 3 boph 4 hr. 500 A F/ 100 boph
Comp. 361 bopd

J. E. TYRA