


Section 20 Township 19 Range 11WWell No. #3 Schartz "A"Company Alpine Oil & Royalty

NORTH

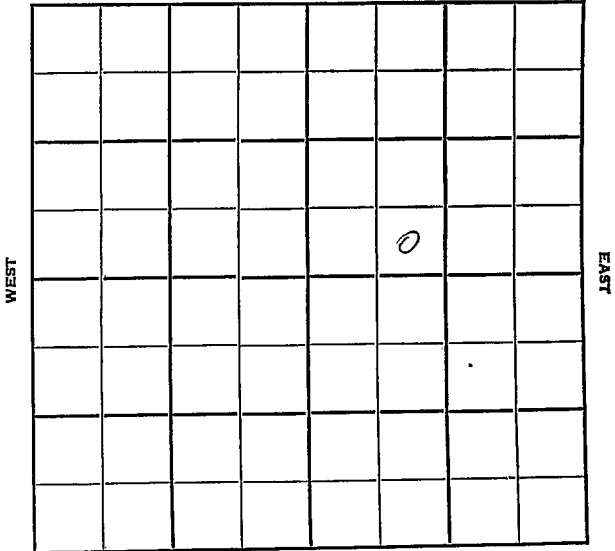

SOUTH

Barton KANSAS

Sec. 20 Twp. 19 R. 11 W ✓

Well No. # 3 Schartz "A" Farm

Alpine Oil & Royalty Company

Quaker Drlg. Contractor

Prairie View Pool


Ft. from N. Line

330 Ft. from S. Line

Ft. from E. Line

990 Ft. from W. Line

SE SW NE

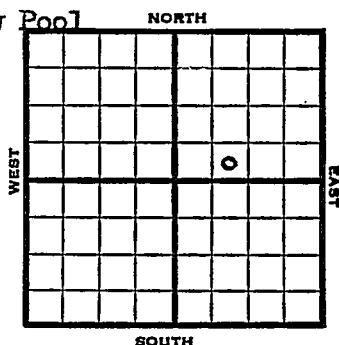

1951

Elev. 1787' REPORT

3/14

Spud 3-9-51
8" @ 225'
Anhy 576'
Drlg. 1530'

4/25

Spud 3-9-51
Oil Well TD 3370
8" @ 225
Anhy 576' Heeb. 2934
Br Lime 3052 Lans. 3069
Cong. 3344-70
5" @ 3369
CO to 3349
24/3214-20 S/10 boph SP 3144
24/3136-42
1000 A FU 1500' oil 10 min.
1000' F/100 BO 3 hr 48/3095-3118
1000 A S/100 bo 3 hr
Comp. 217 bopd 49% wtr.

COMPLETED

J. E. TYRA