

Section 20 Township 19 Range 11-WWell No. #2 Schartz "A"Company Alpine Oil & Royalty

NORTH

WEST

						0	

EAST

SOUTH

Barton

KANSAS

Sec. 20 Twp. 19 R. 11W

Well No. #2 Schartz "A" Farm

Alpine Oil & Royalty Company

Contractor

Prairie View Pool


 Ft. from N. Line

330' Ft. from S. Line

990' Ft. from E. Line

 Ft. from W. Line

SW SE NE

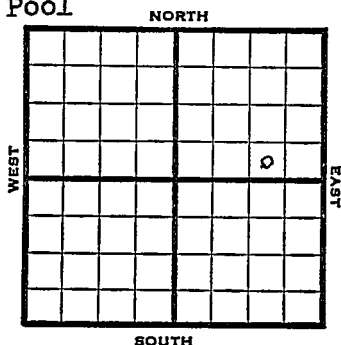

1950 Elev. 1786' REPORT

12/27 Spud 12-22-50
8-5/8" @ 226'
SD

3/14 Spud 12-22-50
Oil Well TD 3377'
8-5/8" @ 226' Heeb. 2936
Br Lime 3057' Lans. 3072
SO 3076-82 3096-3102
Odor 3110-30
DST 3076-3144 opn 45 min. gas in 25
min Rec. 265' hocrn 30' free oil
Arb. 3367-61 5" @ 3358' TD 3377
500 A no inc. SP 3325
16/3313-17 24/3300-06 1000 A
F/10 boph Comp. 171 bopd

COMPLETED

County Barton State Kansas
 Sec. 20 (Blk. 19 (Sur. 11W Map No.
 (Twp.) (Rge.)
 Operator Alpine Oil & Royalty
 Well No. 2 Farm Schartz "A"
 Elev. Location SW SE NE


FIRST REPORT

330 Ft. From S Line NE
990 Ft. From E Line Quarter
 Ist. Report DEC 27 1950
 Completion
 Remarks

Spudding Date 12-22-50
 Drlg. Data Prairie View Pool
8 5/8" @ 226 SD

J. E. TYRA

County Barton State Kansas
 Sec. 20 (Blk. 19) (Sur. 11W) Map No. 11W
 Operator Alpine Oil & Royalty
 Well No. 2 Farm Schartz "A"
 Elev. 1786 Location SW SE NE

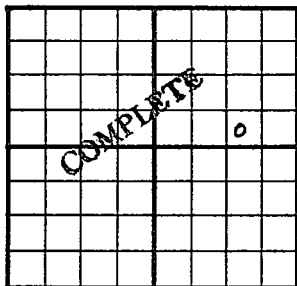

330 Ft. From S Line NE
990 Ft. From E Line Quarter

1st. Report

Completion MAR 14 1951

Remarks Prairie View Pool

Spudding Date 12-22-50

Drlg. Data Oil well TD 3377
8 5/8" @ 226 Heeb. 2936 Br. lime 3057
Lans. 3072 SO 3076-82 3096-3102
Odor 3110-30 DST 3076-3144 open 45 min.
gas in 25 min. Rec. 265' hocom 30' free
oil Arb. 3357-61 5" @ 3358 TD 3377
500 A no inc. SP 3325 16/ 3313-17
24/ 3300-06 1000" A E/ 10 boph
Comp. 171 bopd

J. E. TYRA