


Section 20 Township 19 Range 12W

Well No. 1 Welsh

Company Oil Capital Corp.

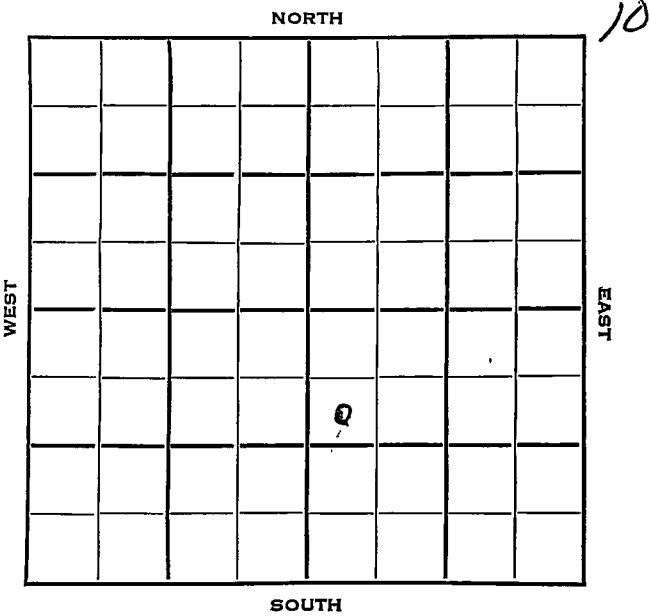

Barton KANSAS

SEC.	TWP.	R.
20	19	12W
WELL NO.		
1 Welsh		FARM
COMPANY		
Oil Capital Corp.		
CONTRACTOR		

H & H

Wildcat


990 Ft. from N. Line

Ft. from S. Line

Ft. from E. Line

330 Ft. from W. Line

SW NW SE

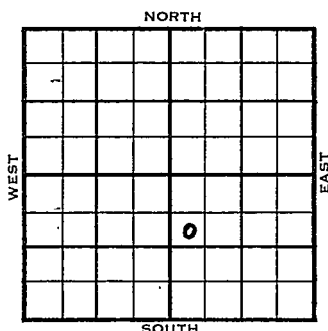

	ELEVATION	REPORT
1954	1892'	
2/3	Spud 2-1-54 Rng surface	
2/10	8" @ 200 w/150 Lost 3 joints surf pipe in hole @ 2031' Fish	
2/17	8" @ 240' w/200 sks Top 2738', Heeb 3079', Br li 3192', Lans 3207' DST 2986-3040', 1 hr., 110' SW + VSSO 1020# DST 3238-77', 1/2 hrs., 840' oil, 60' M, 1170#	
2/24	DST 3277-95', 1/2 hrs., 1945' oil, 1000# DST 3389-95', 10' M DST 3335-47', DP, 5' m, 70# B KC 3427', Arb. 3453' DST 3438-58', 10' m, 530 # RTD 3463', Schl 5" @ 3454'	
3/3	CO 3464' S/17 BOPH 500A S/20 goph DD 3475' 500A	

OVER

1954

4/7

Spud 2-1-54

Oil Well

TD 3463'

8" @ 240'

Top 2738', Heeb 3079', Br. Lime 3192'
Lans 3207'

DST 2986'-3040' opn 1 hr, rec 110' sw
VSSO 1020#

DST 3238'-77' opn $\frac{1}{2}$ hr, rec 840' oil
60' Mud 1170#

DST 3277'-95' opn $\frac{1}{2}$ hr, rec 1945' oil
1000"

DST 3389'-95' rec 10' Mud

DST 3335'-47' rec 5' Mud

70# B KC 3427' Arb 3453'

DST 3438'-58' rec 10' Mud 530#

TD 3463'

5" @ 3454'

CO to 3464'

S/ 17 goph 500 A S/ 20' goph

DD 3475'

500 A S/ $1\frac{1}{2}$ boph 6 hr.

PB 3420'

36/ 3405-11 2000 A S/ 4 boph
6 hr.

PB 3342'

36/ 3278'-84' FU 1900' oil 2 hr.

3000 A S & F 14 boph

S/ 28 boph

Comp 326 bopd.


COMPLETED

County Barton State Kansas
 (Blk.) (Sur.)
 Sec. 20 19 12W Map No.

Operator Oil Capital Corp.

Well No. 1 Farm Welsh

Elev. Location SW NW SE

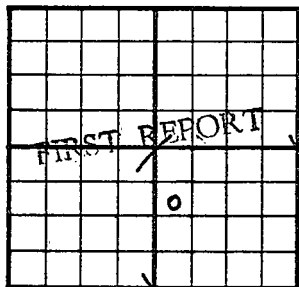

990 Ft. From N Line SE

330 Ft. From N Line Quarter

1st. Report FEB 3 1954

Completion

Remarks

H & H - Contr.

Spudding Date 2-1-54

Drilg. Data Wildcat


eng surface

FEB 4 1954

Scout Cards	10
Land Small Map	
Land Wall Map	3
Tracings	
France Map	
Pierce Map	
Misc.	

Orig. Data

County Barton State Kansas
 Sec. 20 (Blk. 19) (Sur. 12W) Map No. 19
 Operator Oil Capital Corp.
 Well No. 1 Farm Welsh
 Elev. 1892 Location SW NW SE

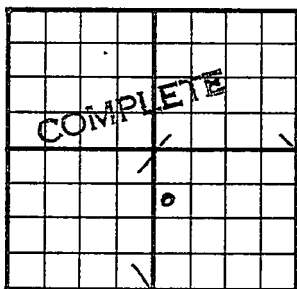

990 Ft. From N Line SE
330 Ft. From W Line Quarter
 Ist. Report APR 7 1954
 Completion Wildcat
 Remarks H & H - Contr.
 Spudding Date 2-1-54

Drilg. Data Oil well TD 3463
8" @ 240 Top. 2738 Heeb. 3079
Br. lime 3192 Lans. 3207 DST 2986-3040
open 1 hr. Rec. 110' sw VSSO 1020#
DST 3238-77 open 1/2 hr. Rec. 840' oil
60' mud 1170# DST 3277-95 open 1/2 hr.
Rec. 1945' oil 1000# DST 3389-95
Rec. 10' mud DST 3335-47 Rec. 5' mud
70# B KC 3427 Arb. 3453 DST 3438-58
Rec. 10' mud 530# TD 3463 5" @ 3454
CO to 3464 - S/ 17 goph 500 A S/ 20 goph
DD 3475 500 A S/ 1 1/2 boph 6 hr.
PB 3420 36/ 3405-11 2000 A S/ 4 boph
6 hr. PB 3342 36/ 3278-84 FU 1900'
oil 2 hr. 3000 A S & F/ 14 boph

J. G. McGEHEE

