

KANSAS


Rice

Section 20 Township 19 Range 10WWell No. 3 ProbstCompany D R Lauck

Chase

NORTH

WEST

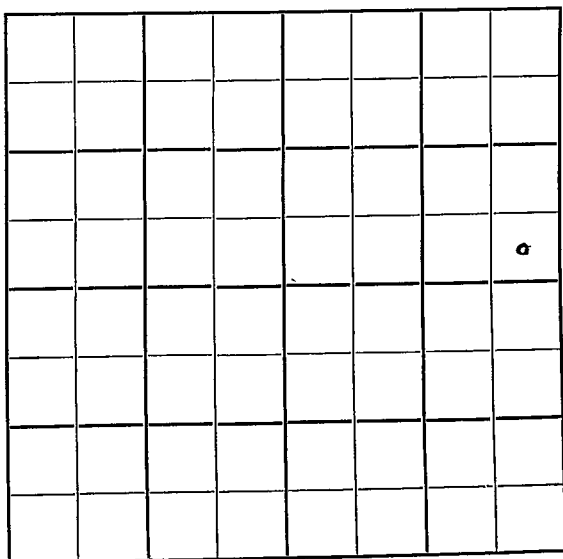

EAST

SOUTH

KANSAS

Rice

Sec. 20 Twp. 19 R. 10W

Well No. #3 Probst Farm

D. R. Lauck Company

Chase Pool

 Ft. from N. Line

330'


 Ft. from S. Line

330'

 Ft. from E. Line

 Ft. from W. Line

SE NE

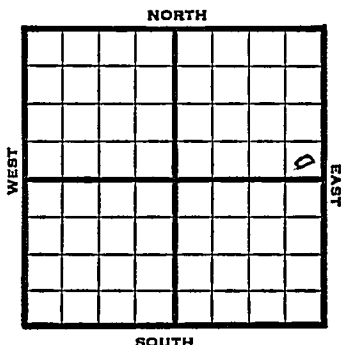

1949 Elev 1767' REPORT

5/4 RUR

5/10 8"@ 133'

Drlg 2740'

5/18 Lansing 2940'

Quartzite 3220-25

TD 3225'

5"@ 3225'

9 shots 3110-25

1000 acid

5/25 TD 3225'

Lans 2940'

Quartzite 3210'

1000 acid

7 M Gas

Comp

COMPLETED

Map No. _____ Sec. 20 Twp. 19 R. 10W

Well No. 3 Probst

W. R. Lauck

Company

FIRST REPORT

Contractor

SE NE

SECTION PLAT

_____ Ft. from N. Line

330 Ft. from S. Line

330 Ft. from E. Line

_____ Ft. from W. Line

Rice County

RECORD

Location _____

Cased _____ in., _____ ft.

Rig up _____

Sand _____

Drilling and Remarks:

Gas _____

R U R

Oil _____

Total Depth _____

PRODUCTION

1st 24 hrs. Nat. _____

1st 24 hrs. after shot _____

Gas _____ Cu. Ft.

Dry Hole _____

Abandoned _____

Date

MAY 4 1949

19

S. J. LEWIS

Scout

Scout Cards

Land Small Map

Land Wall Map

Tracings

France Map

Pierce Map

Misc.

Kansas

Map No. K 46 Sec. 20 Twp. 19 R. 10WWell No. 3 ProbstD. R. Lauck


Company

COMPLETE

Contractor

2-1767

SE NE

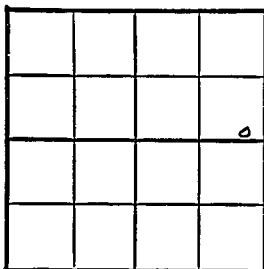SECTION PLAT Ft. from N. Line330 Ft. from S. Line330 Ft. from E. Line Ft. from W. LineRice CountyLocation Rig up

Drilling and Remarks:

Le one 2940
Quartzite 3210
10000 and
7M Gas

RECORDCased in., ft.Sand Gas Oil Total Depth 3225**PRODUCTION**1st 24 hrs. Nat. 1st 24 hrs. after shot Gas Cu. Ft. Dry Hole Abandoned

Date

MAY 25. 194919S. J. LEWIS

Scout

Scout Cards
Land Small Map
Land Wall Map
Tracings
France Map
Pierce Map
Misc.