


Section 20 Township 19 Range 10-W

Well No. #1 Hagger Est.

Company D. R. Lauck

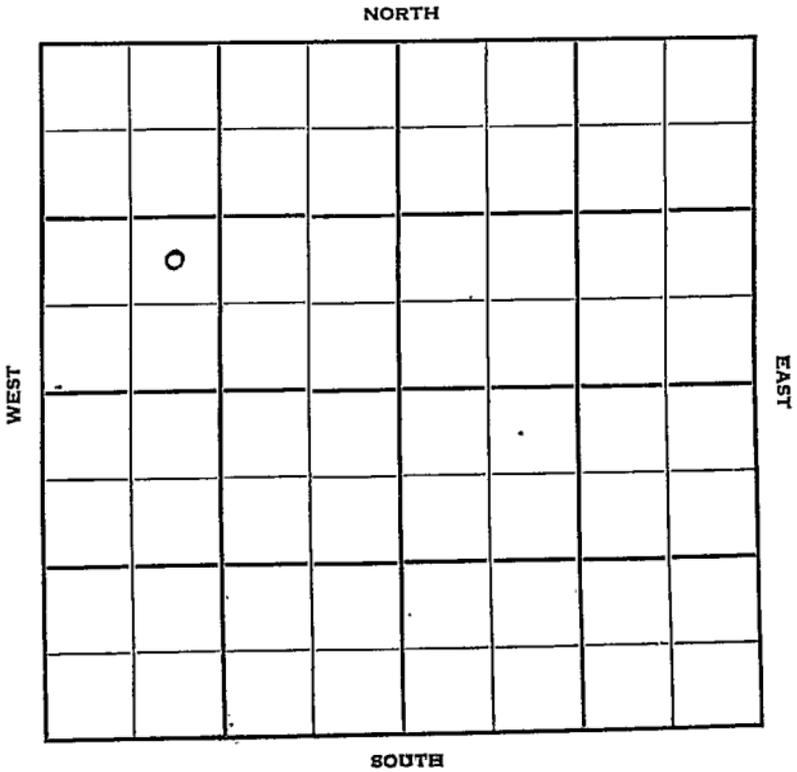

Rice

KANSAS

Sec. 20 Twp. 19 R. 10W ✓

Well No. #1 Hagger Est. Farm

D. R. Lauck Company

Contractor


Ft. from N. Line

990' Ft. from S. Line

Ft. from E. Line

990' Ft. from W. Line

NE SW NW

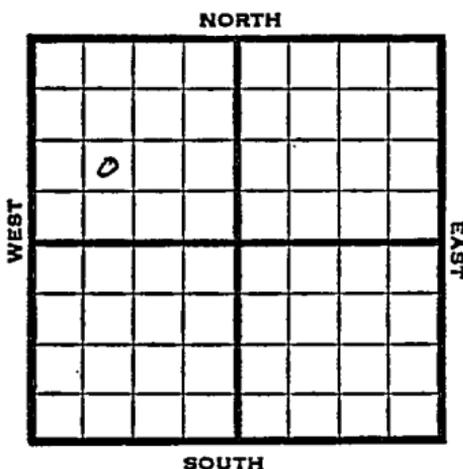

1950

Elev 1776

REPORT

7/5 Spud 7-2-50  
Drlg.

7/19 10 3/4" @ 128

Heeb 2870

Br lime 2989

Lans 3014

DST 3246-51, opn 45 min rec 5' mud

Øong 3324

Arb 3342

DST 3348-61, opn 45 min rec 450' wtr

TD 3388

D&A

**ABANDONED**

Kansas

Map No. \_\_\_\_\_ Sec. 20 Twp. 19 R. 10WWell No. 1 Hagger Est.

\_\_\_\_\_ D. R. Lauck \_\_\_\_\_ Company

\_\_\_\_\_ Contractor

NE SW NW

\_\_\_\_\_ Ft. from N. Line

990 Ft. from S. Line

\_\_\_\_\_ Ft. from E. Line

990 Ft. from W. Line

## SECTION PLAT



Rice County

Location \_\_\_\_\_

Rig up \_\_\_\_\_

Drilling and Remarks:

Spud 7-2-50

drlg.

## RECORD

Cased \_\_\_\_\_ in., \_\_\_\_\_ ft.

Sand \_\_\_\_\_

Gas \_\_\_\_\_

Oil \_\_\_\_\_

Total Depth \_\_\_\_\_

## PRODUCTION

1st 24 hrs. Nat. \_\_\_\_\_

1st 24 hrs. after shot \_\_\_\_\_

Gas \_\_\_\_\_ Cu. Ft.

Dry Hole \_\_\_\_\_

Abandoned \_\_\_\_\_

Date

JUL 5 1950 19 J. E. TYRA Scout

Scout Cards

Land Small Map

Land Wall Map

Tracings

France Map

Pierce Map

Misc.

JUL 7 1953

Kansas

Map No. \_\_\_\_\_ Sec. 20 Twp. 19 R. 10W

Well No. 1 Hagger Est.

D. R. Lauck

Company

Contractor

NE SW NW

El. 1776  
SECTION PLAT

\_\_\_\_\_ Ft. from N. Line


990

Ft. from S. Line

\_\_\_\_\_ Ft. from E. Line

990

Ft. from W. Line

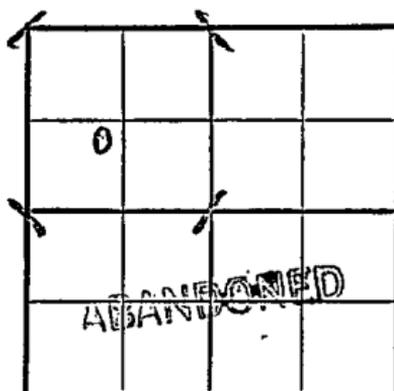

Rice County

Location \_\_\_\_\_

Rig up \_\_\_\_\_

Drilling and Remarks:

10 3/4" @ 128

Heeb. 2870

Br. lime 2989

Lans. 3014

DST 3246-51

open 45 min.

Rec. 5<sup>r</sup> mud

## RECORD

Cased \_\_\_\_\_ in., \_\_\_\_\_ ft.

Sand \_\_\_\_\_

Gas \_\_\_\_\_

Oil \_\_\_\_\_

Total Depth 3388

## PRODUCTION

1st 24 hrs. Nat. \_\_\_\_\_

1st 24 hrs. after shot \_\_\_\_\_

Gas \_\_\_\_\_ Cu. Ft.

Dry Hole \_\_\_\_\_

Abandoned \_\_\_\_\_

Date

JUL 19 1950

19

J. E. TYRA

Scout

