


KANSAS Rice

Section 20 Township 19 Range 20-W

Well No. #4 Probst

Company D R Lauck
Silica Pool

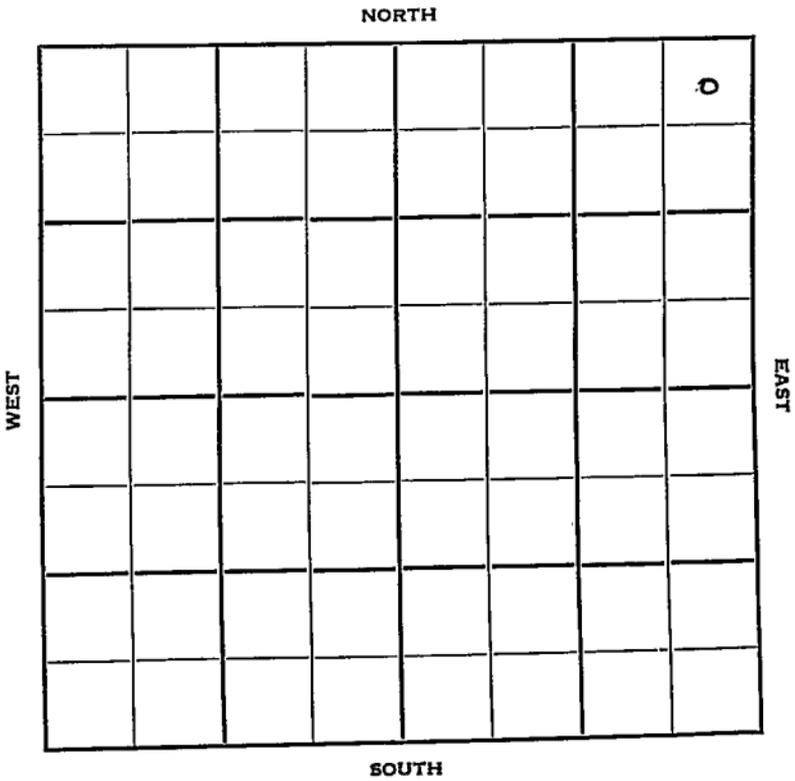

Rice

19

20

R. 10W

Sec. _____ Twp. _____ R. _____

Well No. #4 Probst _____ Farm

D. R. Lauck _____ Company

Contractor

Silica Pool


330' Ft. from N. Line

_____ Ft. from S. Line

330' Ft. from E. Line

_____ Ft. from W. Line

NORTH

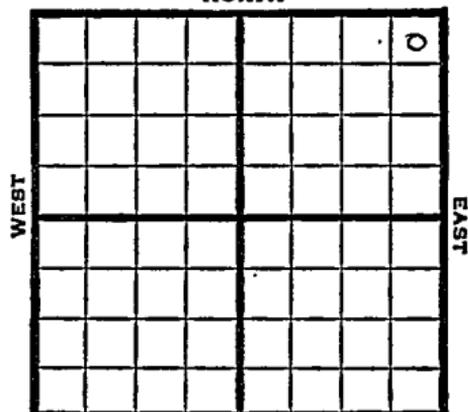

SOUTH

NE NE NE

1950

Elev 1768'

REPORT

3/8

RUR

4/5

TD 3398'

10" @ 132'

5" @ 3398'

Heeb 2848'

Lans 2985'

Cong 3315'

Arb. 3356'

50 BOPD

Comp

COMPLETED

Kansas

Silica Pool

Map No. _____ Sec. 20 Twp. 19 R. 10W

Well No. 4 Probst

D. R. Lauck Company

Contractor

NE NE NE

El. 1768
SECTION PLAT

330 Ft. from N. Line

_____ Ft. from S. Line

330 Ft. from E. Line

_____ Ft. from W. Line



Rice County

Location _____

Rig up _____

Drilling and Remarks:

R U R

RECORD

Cased _____ in., _____ ft.

Sand _____

Gas _____

Oil _____

Total Depth _____

PRODUCTION

1st 24 hrs. Nat. _____

1st 24 hrs. after shot _____

Gas _____ Cu. Ft.

Dry Hole _____

Abandoned _____


Date

MAR 8 1950 19

J. E. TYRA Scout



 



- Scout Cards
- Land Small Map
- Land W. S. M.
- Tracings
- France Map
- Pierce Map
- Misc.

MAR 20 1950

Kansas

Silica Pool

Map No. _____ Sec. 20 Twp. 19 R. 10W

Well No. 4 Probst

D. R. Lauck

Company

Contractor

NE NE NE

E. 1768
SECTION PLAT


330 Ft. from N. Line

_____ Ft. from S. Line

330 Ft. from E. Line

_____ Ft. from W. Line

Rice County

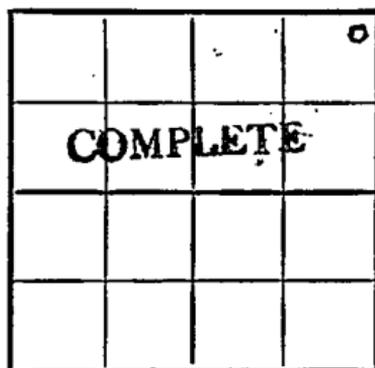

Location _____

Rig up _____

Drilling and Remarks:

10" @ 132

5" @ 3398

Kub 2848

Laws 2985

Cing 3315

Rnb 3356

RECORD

Cased _____ in., _____ ft.

Sand _____

Gas _____

Oil _____

Total Depth 3398

PRODUCTION

1st 24 hrs. Nat. _____

1st 24 hrs. after shot _____

Gas _____ Cu. Ft.

Dry Hole _____

Abandoned _____

Date

50 BOPD
APR 5 1950 19J. E. TYRA
Scout

TELEPHONE



LI VI

I

CA N I

A F I

REF C

APR 14 1959

Scout Cards	<i>Coill</i>
Land Smail Map	
Land Wall Map	<i>3</i>
Tracings	
France Map	
Pierce Map	
Misc.	