

# KANSAS

Rice

Section 20 Township 19 Range 9W

Well No. 2 Doll

Company J.C. Dozier

Chase  
NORTH

		0					

WEST

EAST

SOUTH

Rice **KANSAS**

Sec. 20 Twp. 19 R. 9W ✓


Well No. #2 Doll Farm

J. C. Dozier

Company

Chase Pool (Lewis, Cont.)

330' Ft. from N. Line

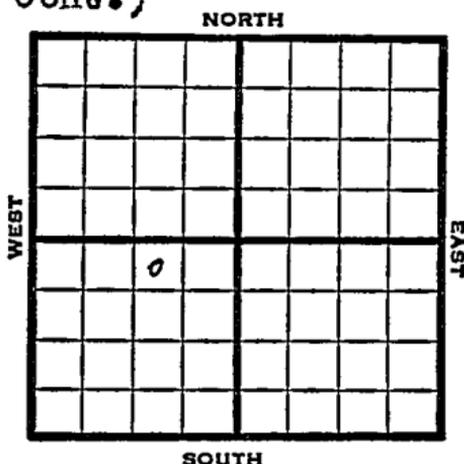

\_\_\_\_\_ Ft. from S. Line

990' Ft. from E. Line

\_\_\_\_\_ Ft. from W. Line

NW NE SW

1949

Elev. 1727' REPORT

- 5/25 Location
- 6/1 Surface hole
- 6/7 8" @ 162'  
Lansing 2900'
- 6/15 Drlg. 3000'  
TD 3243  
5" @ 3223'  
Swb 2 bbls oil PH 3 hrs.
- 6/22 Lans. 2900'  
5" @ 3223'  
Arb. 3222'  
Pump 25 oil Pot.  
Gr. 420  
TD 3247'

**COMPLETED**

Map No. \_\_\_\_\_ Sec. 20 Twp. 19 R. 9W

Well No. 2 Doll

J. C. Dozier Company

Lewis Contractor

NW NE SW

FIRST REPORT  
SECTION PLAT

330 Ft. from N. Line

\_\_\_\_\_ Ft. from S. Line

990 Ft. from E. Line

\_\_\_\_\_ Ft. from W. Line

	o		

Rice County

Location X

Rig up \_\_\_\_\_

Drilling and Remarks:

RECORD

Cased \_\_\_\_\_ in., \_\_\_\_\_ ft.

Sand \_\_\_\_\_

Gas \_\_\_\_\_

Oil \_\_\_\_\_

Total Depth \_\_\_\_\_

PRODUCTION

1st 24 hrs. Nat. \_\_\_\_\_

1st 24 hrs. after shot \_\_\_\_\_

Gas \_\_\_\_\_ Cu. Ft.

Dry Hole \_\_\_\_\_

Abandoned \_\_\_\_\_

Date

MAY 25 1949 19

S. J. LEWIS Scout

KANSAS

Map No. 149 Sec. 20 Twp. 19 R. 9WWell No. 2 DollJ. C. Dozier Company**COMPLETE**

Contractor

NW NE SW

E1, 1727  
SECTION PLAT330 Ft. from N. Line

\_\_\_\_\_ Ft. from S. Line

990 Ft. from E. Line

\_\_\_\_\_ Ft. from W. Line

	o		

Rice County**RECORD**

Location \_\_\_\_\_

Cased \_\_\_\_\_ in., \_\_\_\_\_ ft.

Rig up \_\_\_\_\_

Sand \_\_\_\_\_

Drilling and Remarks:

Gas \_\_\_\_\_

Oil \_\_\_\_\_

Total Depth 3247**PRODUCTION**

1st 24 hrs. Nat. \_\_\_\_\_

1st 24 hrs. after shot \_\_\_\_\_

Gas \_\_\_\_\_ Cu. Ft.

Dry Hole \_\_\_\_\_

Abandoned \_\_\_\_\_

Date

JUN 22 194919S. J. LEWIS Scout

Have 2900  
5" 2223  
Car 83222  
Pay 25 oil 1st  
42 2/3