


*Rice*

Map No. **KANSAS** Sec. *20* Twp. *19* R. *9W*

Well No. *1- Habiger* Farm  
*Empire Oil* Company

NORTH

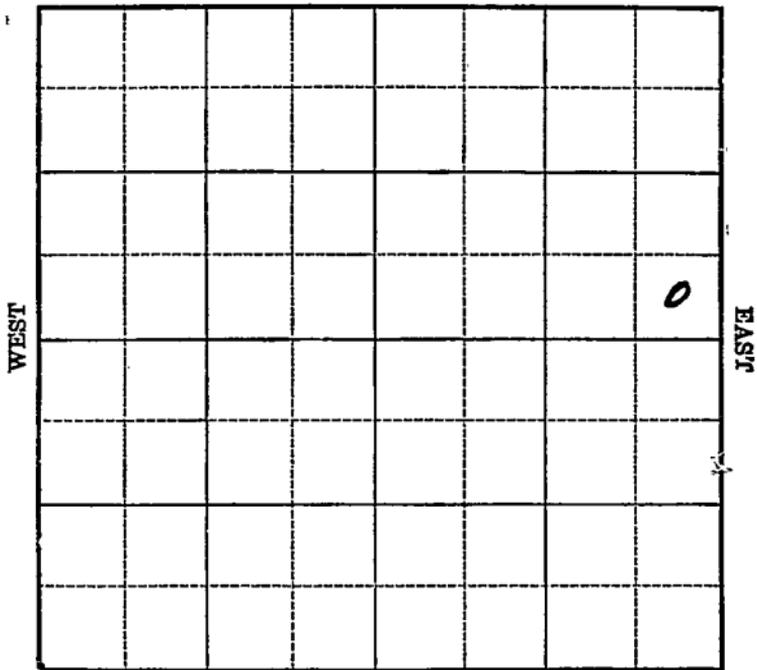

SOUTH

Location \_\_\_\_\_

Drilling Remarks \_\_\_\_\_  
\_\_\_\_\_  
\_\_\_\_\_  
Rig Up \_\_\_\_\_

Drilling Remarks \_\_\_\_\_  
\_\_\_\_\_  
\_\_\_\_\_  
**RECORD**

Cased \_\_\_\_\_ in. \_\_\_\_\_ ft.

Sand \_\_\_\_\_

Gas \_\_\_\_\_

Oil \_\_\_\_\_

Total Depth \_\_\_\_\_

**PRODUCTION**

1st 24 hrs. Nat. \_\_\_\_\_

1st 24 hrs. after shot \_\_\_\_\_

Gas \_\_\_\_\_ cu. ft.

Dry Hole \_\_\_\_\_


Abandoned \_\_\_\_\_

Rice

Map No. KANSAS Sec. 20 Twp. 19 R. 9W

Well No. 1- Habiger Farm  
Empire Oil Company

\_\_\_\_\_ Ft. from N. Line  
330 Ft. from S. Line  
330 Ft. from E. Line  
\_\_\_\_\_ Ft. from W. Line

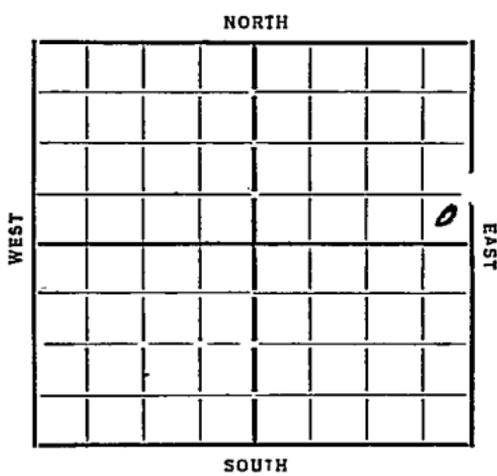

Date	REPORT
1935	
5/8	Location
5/16	—
5/23	Rig 20" 140
5/29	Dlg 300 15" 342
6/6	" 1380 12" 1175
6/13	" 2010 10" 1898
6/20	" 2320 10" 4235
6/28	" 3080
7/3	8" 3192
7/11	Oil 3238
	3257 2200 19 hrs 1000 acid
7/18	P 1037 Hbls 16 hrs.
7/24	Oil 3238
	T 7 3257
	pump 150% oil
	trace water
	<b>COMPLETED</b>

Map No. 49 Sec. 20 Twp. 19 R. 9W

Well No. 1- Habiger

Empire oil Company

Contractor

**FIRST REPORTS**

**SECTION PLAT**


..... Ft. from N. Line

330 Ft. from S. Line

330 Ft. from E. Line

..... Ft. from W. Line

Location

Rig up .....

Drilling and Remarks:

**RECORD**

Cased.....in., .....ft.

Sand.....

Gas.....

Oil.....

Total Depth.....

**PRODUCTION**

1st 24 hrs. Nat.....

1st 24 hrs. after shot.....

Gas..... Cu. Ft.

Dry Hole.....

Abandoned.....

Date

5-8-35 192

ORVAL MANNSCHRECK

Scout

*no*  
*no*

Returned.....	
Cards.....	<i>MS</i>
Tracing.....	<i>MS</i>
France Map.....	<i>X</i>
Scarborough Map.....	<i>X</i>
Moody Map.....	<i>X</i>
Scarborough Plat Book.....	
Moody Plat Book.....	

Map No. 49 Sec. 20 Twp. 19 R. 9W

Well No. 1 Hatiger

Empire Oil Company

Contractor

**PLANNED**

SECTION PLAT

..... Ft. from N. Line

330 Ft. from S. Line

330 Ft. from E. Line

..... Ft. from W. Line

			0

Location.....

Rig up.....

Drilling and Remarks:

*Oil 3238.  
Pump 1503 oil  
Trace water*

RECORD

Cased..... in., ..... ft.

Sand.....

Gas.....

Oil.....

Total Depth. 3257

PRODUCTION

1st 24 hrs. Nat.....

1st 24 hrs. after shot.....

Gas..... Cu. Ft.

Dry Hole.....

Abandoned.....

Date

7/24/35 192

**ORIGINAL MANUSCRIPT**

Scout

*no  
miscellaneous*

Returned	<i>RAJ</i>
Cards	<i>RAJ</i>
Tracing	<i>RAJ</i>
France Map	<i>X</i>
Scarborough Map	<i>X</i>
Moody Map	<i>X</i>
Scarborough Plat Book	
Moody Plat Book	

Map No. 49 Sec. 20 Twp. 19 R. 9W

Well No. 1 Naeger

Empire Oil Company

Contractor

SECTION PLAT

	4		0

\_\_\_\_\_ Ft. from N. Line

330 Ft. from S. Line

330 Ft. from E. Line

\_\_\_\_\_ Ft. from W. Line

FIRST REPORT

Location ✓

Rig up \_\_\_\_\_

Drilling and Remarks:

RECORD

Cased \_\_\_\_\_ in., \_\_\_\_\_ ft.

Sand \_\_\_\_\_

Gas \_\_\_\_\_

Oil \_\_\_\_\_

Total Depth \_\_\_\_\_

PRODUCTION

1st 24 hrs. Nat. \_\_\_\_\_

1st 24 hrs. after shot \_\_\_\_\_

Gas \_\_\_\_\_ Cu. Ft.

Dry Hole \_\_\_\_\_

Abandoned \_\_\_\_\_

Date

5/8/25 19

W. Lewis Scout



*RAY*

*2*

Returned	<i>[Signature]</i>
Cards	<i>[Signature]</i>
Tracing	<i>[Signature]</i>
France Map	<i>[Signature]</i>
Scarborough Map	<i>[Signature]</i>
Moody Map	
Scarborough Plat Book	
Moody Plat Book	

*[Signature]*

KANSAS

M. 10 Sec. 20 Twp. 19 R. 9W

Well No. 1 Habiger

Empire Oil Company

Contractor

SECTION PLAT


\_\_\_\_\_ Ft. from N. Line

330 Ft. from S. Line

330 Ft. from E. Line

First Ft. from W. Line

COMPLETED

Location \_\_\_\_\_

Rig up \_\_\_\_\_

Drilling and Remarks:

Oil 3238.

Pa 81503

trace water

RECORD

Cased \_\_\_\_\_ in., \_\_\_\_\_ ft.

Sand \_\_\_\_\_

Gas \_\_\_\_\_

Oil \_\_\_\_\_

Total Depth 3257

PRODUCTION

1st 24 hrs. Nat. \_\_\_\_\_

1st 24 hrs. after shot \_\_\_\_\_

Gas \_\_\_\_\_ Cu. Ft.

Dry Hole \_\_\_\_\_

Abandoned \_\_\_\_\_

Date

July 24/3519

J. L. Lewis

Scout

We have never received a first report on this ticket.

Lewis: Check and Advise

We show a completed well in SE NE 20-20-9W. If you are referring to this completed well we already have a completed ticket.

Do you mean to correct location if so please let us have a correction ticket so the Geol. and Eng. Dept. can make correction on their maps

He sent us a  
First Report  
Completing

Returned	<input checked="" type="checkbox"/>
Cards	<input checked="" type="checkbox"/>
Tracing	<input checked="" type="checkbox"/>
France Map	<input checked="" type="checkbox"/>
Scarborough Map	<input checked="" type="checkbox"/>
Moody Map	<input checked="" type="checkbox"/>
Scarborough Plat Book	<input type="checkbox"/>
Moody Plat Book	<input type="checkbox"/>