


KANSAS Rice

Section 20 Township 19 Range 9W

Well No. 1 Habiger

Company Derby Drlg
Chase

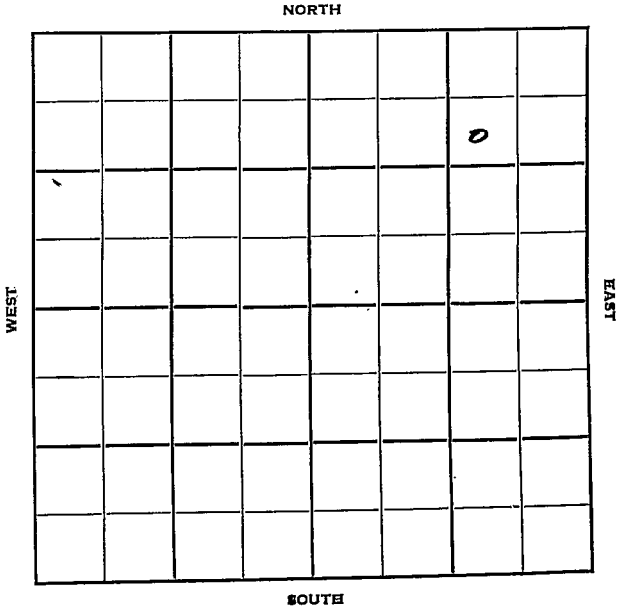



Sec. 20 Twp. 19 R. 9W

Well No. #1 Habiger Farm

Derby Drlg. Company

Chase Pool


990' Ft. from N. Line

_____ Ft. from S. Line

990' Ft. from E. Line

_____ Ft. from W. Line

SW NE NE

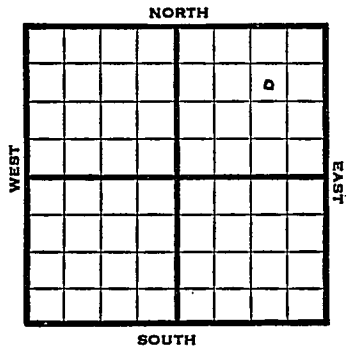

1949 Elev 1720' REPORT

- 4/27 8" @ 168'
- Drlg. 2050'
- 5/4 Lansing 2901'
- Arb. 3241-48'
- TD 3248'
- 5" @ 3242'
- 5/10 Swb 3 bbls oil PH
- 5/18 Pump 64 bbls oil 18 hrs.
- 5/25 TD 3248'
- Arb. 3241'
- 5 @ 3242'
- Pump 45 Oil / 3% W Pot
- 42⁰ Gr.
- Comp

COMPLETED

Map No. _____ Sec. 20 Twp. 19 R. 9W

Well No. 1 Habiger

Derby Drlg. _____ Company

FIRST REPORT

Contractor _____

SW NE NE

SECTION PLAT

990 Ft. from N. Line

_____ Ft. from S. Line

990 Ft. from E. Line

_____ Ft. from W. Line

Rice County

Location _____

Rig up _____

Drilling and Remarks:

8" @ 168

drlg. 2050

RECORD

Cased _____ in., _____ ft.

Sand _____

Gas _____

Oil _____

Total Depth _____

PRODUCTION

1st 24 hrs. Nat. _____

1st 24 hrs. after shot _____

Gas _____ Cu. Ft.

Dry Hole _____

Abandoned _____

Date

APR 27 1949 19

S. J. LEWIS Scout

Map No. K49 Sec. 20 Twp. 19 R. 9W

Well No. 1 Habiger

Derby Drlg. Company

COMPLETE

Contractor

SW NE NE

E11720

SECTION FLAT

990 Ft. from N. Line

_____ Ft. from S. Line

990 Ft. from E. Line

_____ Ft. from W. Line

Rice County

Location _____

Rig up _____

Drilling and Remarks:

Cor 83241

5" @ 3242

Prng 45 oil to 3700

SD

42 0/82

RECORD

Cased _____ in., _____ ft.

Sand _____

Gas _____

Oil _____

Total Depth 3248

PRODUCTION

1st 24 hrs. Nat. _____

1st 24 hrs. after shot _____

Gas _____ Cu. Ft.

Dry Hole _____

Abandoned _____

Date

MAY 25 1949 19

S. J. LEWIS

Scout