

# KANSAS


Rice

Section 20 Township 19 Range 9-W

Well No. #1 Troffitt

Company Aylward Production

Chase pool NORTH

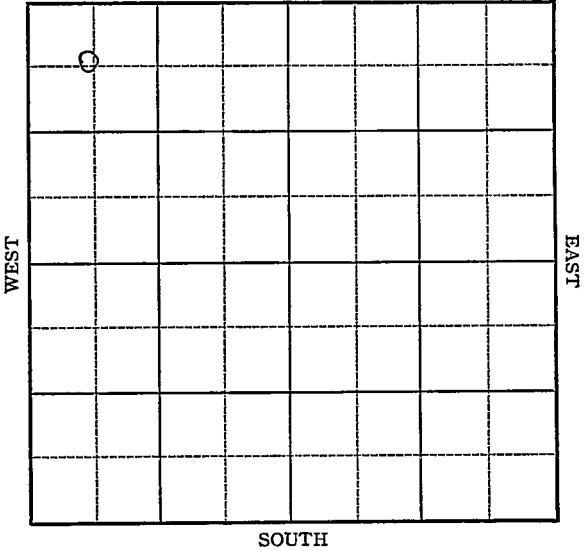

Sec. 20 Twp. 19 R. 9W

Well No. #1 Proffitt Farm

Aylward Production Company


Chase Pool

550 Ft. from N. Line

\_\_\_\_\_ Ft. from S. Line

\_\_\_\_\_ Ft. from E. Line

550 Ft. from W. Line

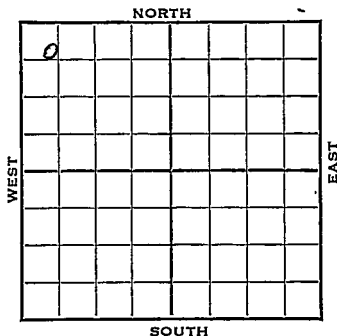

C NW NW

1942

REPORT

11/10 Drlg. 1550'  
8" - 230'

11/18 Lans 2918  
SSD  
Arp 3247  
sab  
TD 3265  
5" @ 3248 rust

11/24 600' oil

12/2 "

12/9 12 shots 2985-89  
swb 15 oil 65 water a day

12/16 " " "

12/22 Lans. 2918  
Arb. 3247  
5" @ 3248'  
T.D. 3265'  
Pump Pot. 527  
12 shots 2985-89  
1000 acid  
Pump 65 bbls. oil plus 120 bbls. wtr.  
Gravity 43.4  
Produce from two zones.

**COMPLETED**

KANSAS

Map No. 49 Sec. 20 Twp. 19 R. 9WWell No. 1 ProffittAylward Production CompanyFIRST REPORT Contractor

C NW NW

550 Ft. from N. Line         Ft. from S. Line         Ft. from E. Line550 Ft. from W. Line

## SECTION PLAT

D			

## CHASE POOL

Location                                 Rig up                                 

Drilling and Remarks:

8" -230'

Drlg. 1550'

## RECORD

Cased                  in.,                  ft.Sand                                 Gas                                 Oil                                 Total Depth                                 

## PRODUCTION

1st 24 hrs. Nat.                                 1st 24 hrs. after shot                                 Gas                                  Cu. Ft.Dry Hole                                 Abandoned                                 

Date

NOV 1 1 1942 19S. J. LEWIS Scout

**KANSAS**

Rice

Map No. 49 Sec. 20 Twp. 19 R. 9W

Well No. 1 Proffitt

Aylward Production Company

**COMPLETED** Contractor

C NW NW

**SECTION PLAT**

550 Ft. from N. Line

0			

\_\_\_\_\_ Ft. from S. Line

\_\_\_\_\_ Ft. from E. Line

550 Ft. from W. Line

**CHASE POOL**

**RECORD**

Location \_\_\_\_\_

Cased \_\_\_\_\_ in. \_\_\_\_\_ ft.

Rig up \_\_\_\_\_

Sand \_\_\_\_\_

Drilling and Remarks:

Gas \_\_\_\_\_

*Lease 29A  
 Cr 43247  
 5" @ 3248 1000 acid  
 Pump Prod. 527.  
 12 skts. 2985-88  
 1000 acid  
 Pump 65 oil + 12 water  
 434, 29*

Oil \_\_\_\_\_

Total Depth 2265

**PRODUCTION**

1st 24 hrs. Nat. \_\_\_\_\_

1st 24 hrs. after shot \_\_\_\_\_

Gas \_\_\_\_\_ Cu. Ft.

Dry Hole \_\_\_\_\_

Abandoned \_\_\_\_\_

*Produce from 200 gavel*

Date \_\_\_\_\_

DEC 22 1942 19

**S. J. LEWIS** Scout