

KANSAS

Rice


Section 20 Township 19 Range 9W

Well No. 1 Doll

Company J C Dozier

Chase

NORTH

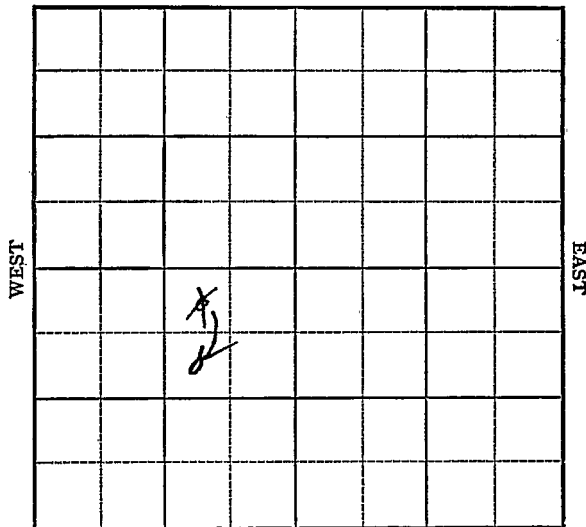

SOUTH

KANSAS

Rice



Sec. 20 Twp. 19 R. 9W


Well No. #1 Doll Farm

J. C. Dozier Company

Chase Pool

NORTH

~~330~~ 490 Ft. from N. Line

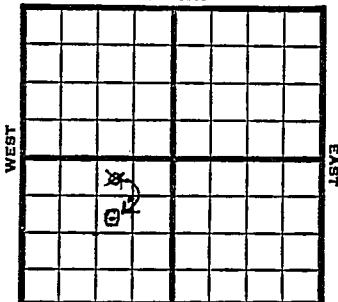

Ft. from S. Line

990 Ft. from E. Line

Ft. from W. Line

NW NE SW *SW NE SW*

SOUTH

1949

Elev 1725' REPORT

3/9

Location

3/16

10" @ 74
Drlg 1857'

3/23

Lansing 2908'
Drlg. 3203'

3/30

Arb. 3222'
5" @ 3222
TD 3230'
1000(oil 12 hrs.

4/6

TD 3230'
Arb. 3222'
5" @ 3222'
500 Acid
Pump 50 Pot
42° Gr.

Comp

COMPLETED

Kansas

Map No. _____ Sec. 20 Twp. 19 R. 9WWell No. 1 DollJ. C. Dozier Company

FIRST REPORT

Contractor

NW NE SW

SECTION PLAT

330 Ft. from N. Line

_____ Ft. from S. Line

990 Ft. from E. Line

_____ Ft. from W. Line

	a		

Rice County

Location X

Rig up _____

Drilling and Remarks:

RECORD

Cased _____ in., _____ ft.

Sand _____

Gas _____

Oil _____

Total Depth _____

PRODUCTION

1st 24 hrs. Nat. _____

1st 24 hrs. after shot _____

Gas _____ Cu. Ft.

Dry Hole _____

Abandoned _____

Date

MAR 9 1949 19S. J. LEWIS Scout

Map No. _____ Sec. 20 Twp. 19 R. 9W

Well No. 1 Doll

J. C. Dozier Company

CORRECTION Contractor

SW NE SW

SECTION PLAT

990 Ft. from N. Line

_____ Ft. from S. Line

990 Ft. from E. Line

_____ Ft. from W. Line

Rice County

Location _____

Rig up _____

Drilling and Remarks:

Reported

NW NE SW

RECORD

Cased _____ in., _____ ft.

Sand _____

Gas _____

Oil _____

Total Depth _____

PRODUCTION

1st 24 hrs. Nat. _____

1st 24 hrs. after shot _____

Gas _____ Cu. Ft.

Dry Hole _____

Abandoned _____

Date

MAR 23 1949 19

S. J. LEWIS

Scout

