

Map No. **KANSAS** Sec. **20** Twp. **19** R. **9W**Well No. **25 doll** Farm**Lebow itab** Company

NORTH

WEST

EAST

SOUTH

Location

Drilling Remarks

Rig Up

Drilling Remarks

RECORD

Cased _____ in. _____ ft.

Sand _____

Gas _____

Oil _____

Total Depth _____

PRODUCTION

1st 24 hrs. Nat. _____

1st 24 hrs. after shot _____

Gas _____ cu. ft.

Dry Hole _____


Abandoned _____

Rice

Map No. KANSAS Sec. 20 Twp. 19 R. 9W

Weil No. 2- Roll Farm
Lebow et al Company

NORTH

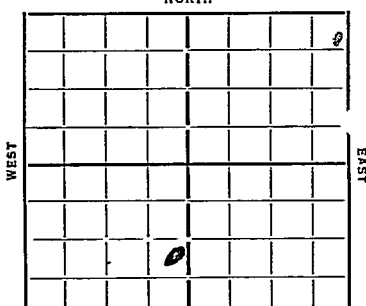

SOUTH

 Ft. from N. Line

990 Ft. from S. Line

330 Ft. from E. Line

 Ft. from W. Line

Elev. 1721

Date 1935

REPORT

5/8 Location
5/16 Cellar
5/23 Material
5/29 Rig
6/6
6/13 Spud
6/20 Dlg 835 15" 331
6/28 12" 1539 Dlg
7/3 Dlg 2050 12" 1540
7/11 10" 2170 rw 2194
2245 U.R.
7/18 Dlg 2800 10" 2236
7/26 KOC 2910 8" 2920
2019 2927 1000' Oil 2952
8/1 6" 3246 Sil 3246
Oil 3265 Pay 3281- 86
1700' oil CO.
8/8
8/14 Sil 3246
77 3286
275 blk.

COMPLETED

Map No. 49 Sec. 20 Twp. 19 R. 9NWell No. 2- Pole
Schow et al Company

Contractor

FIRST REPORTS

SECTION PLAT

Ft. from N. Line

990 Ft. from S. Line330 Ft. from E. Line

Ft. from W. Line

Location ☒

Rig up

Drilling and Remarks:

RECORD

Cased _____ in., _____ ft.

Sand _____

Gas _____

Oil _____

Total Depth _____

PRODUCTION

1st 24 hrs. Nat. _____

1st 24 hrs. after shot _____

Gas _____ Cu. Ft.

Dry Hole _____

Abandoned _____

Date

ORVAL MANNSCHRECK

5-8-35 192

Scout

Map No. 49 Sec. 20 Twp. 19 R. 9WWell No. 2-DallLehman et al Company

Contractor

COMPLETED

SECTION PLAT

Ft. from N. Line

990 Ft. from S. Line330 Ft. from E. Line

Ft. from W. Line

Location

Rig up

Drilling and Remarks:

275 ft

RECORD

Cased in. ft.

Sand Sil 3246

Gas

Oil

Total Depth 3286

PRODUCTION

1st 24 hrs. Nat.

1st 24 hrs. after shot

Gas Cu. Ft.

Dry Hole

Abandoned

Date

8-14-35 192

ORVAL MANNSCHRECK

Scout