


Section 20 Township 19 Range 9-W

Well Number #2 Habiger

Company Empire

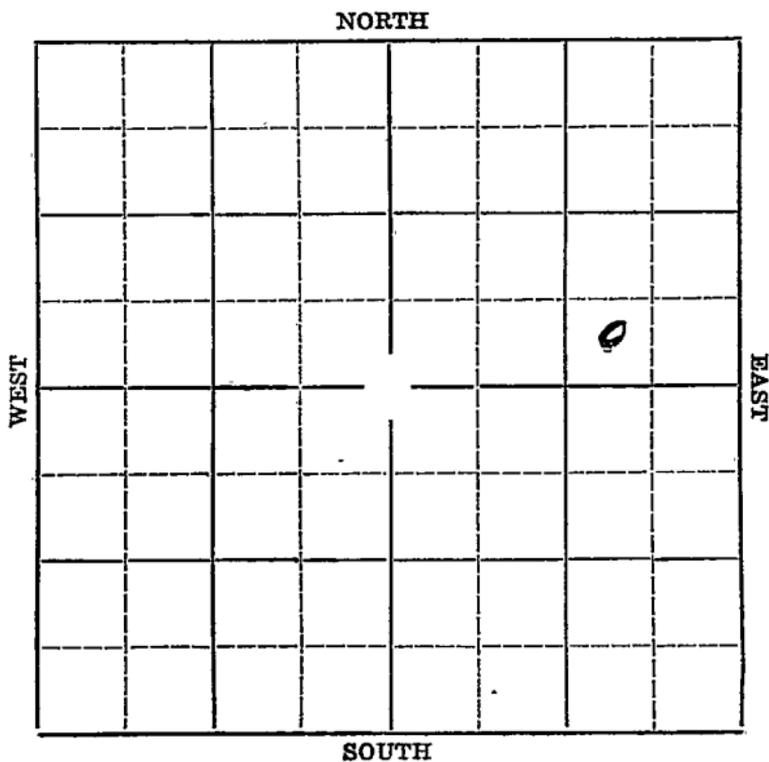

Sec. 20 Twp. 19 R. 9W

Well No. #2 Habiger Farm

Empire Company


_____ Ft. from N. Line

330' Ft. from S. Line

990' Ft. from E. Line

_____ Ft. from W. Line

Elev. 1722

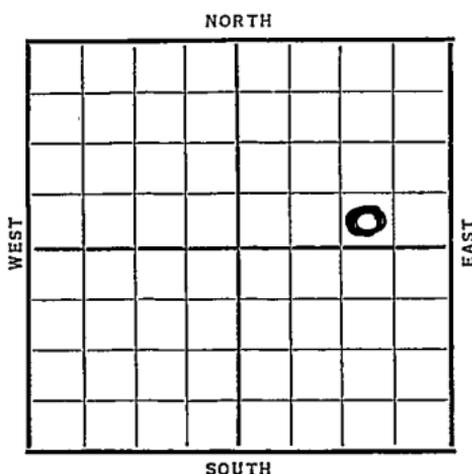

1966

REPORT

10/21 10" @ 256'.

Drlg. 1140'.

11/6 Sil. 3231 7" @ 3232 Rust

11/12----

11/18 Sil 3231 T. D. 3245

2000 acid. Pot. 1376

COMPLETED

Map No. 49 Sec. 20 Twp. 19 R. 9WWell No. 2 HagerEngineer Company

Contractor

SECTION PLAT

			o

_____ Ft. from N. Line

330 Ft. from S. Line990 Ft. from E. Line

_____ Ft. from W. Line

FIRST REPORT

RECORD

Location _____

Cased _____ in., _____ ft.

Rig up _____

Sand _____

Drilling and Remarks:

Gas _____

Oil _____

Total Depth _____

10" @ 256

PRODUCTION

1st 24 hrs. Nat. _____

1st 24 hrs. after shot _____

Gas _____ Cu. Ft.

Dry Hole _____

Abandoned _____

July 11/40

Date

Oct 21 / 36 19J. Lewis Scout

Map No. 49 Sec. 20 Twp. 19 R. 9W

Well No. 2 Hatiger

Empire Company

Contractor

SECTION PLAT

			0

_____ Ft. from N. Line

320 Ft. from S. Line

990 Ft. from E. Line

_____ Ft. from W. Line

COMPLETED

Location _____

RECORD

Cased _____ in., _____ ft.

Sand _____

Gas _____

Oil _____

Total Depth 3245

PRODUCTION

1st 24 hrs. Nat. _____

1st 24 hrs. after shot _____

Gas _____ Cu. Ft.

Dry Hole _____

Abandoned _____

Rig up _____

Drilling and Remarks:

Oil 3231

2000 acid

P 8/1376

Date

NOV 18 1936 19

S. J. LEWIS Scout