

KANSAS


Rice

FORM 51 5M 1-42 PETROL

Section 20 Township 19 Range 9-W

Well No. #2 Rolfs

Company Aylward Production

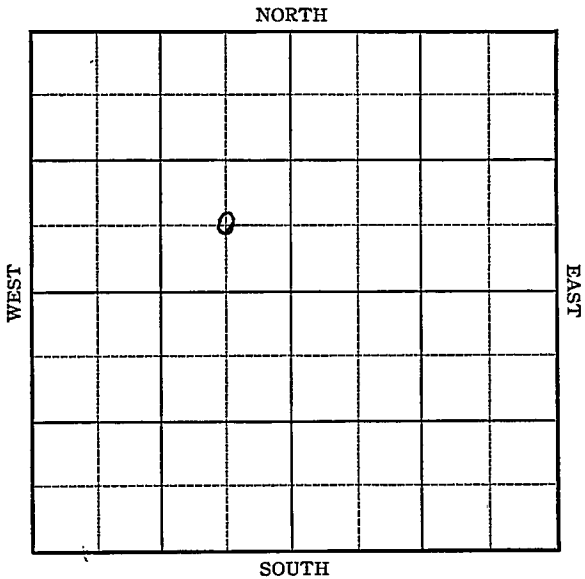

KANSAS

Rice

Sec. 20 Twp. 19 R. 9-W

Well No. #2 Rolfs Farm

Aylward Production Company


 Ft. from N. Line

660 Ft. from S. Line

660 Ft. from E. Line

 Ft. from W. Line

Elev. 1728

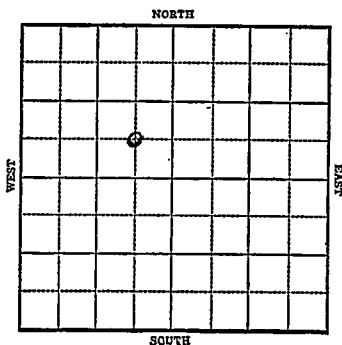

1943

R E P O R T

5/5

8" @ 245'
Drlg. 1610'

5/12

Lans 2911
Arb 3249-52 T.D.
5" @ 3248 Rust.

5/19

Arb. 3249
5" - 3248
Pump 85 Pot.
T.D. 3262
Gravity 42.5

COMPLETED

KANSAS

Rice

Map No. 49 Sec. 20 Twp. 19 R. 9WWell No. 2 RolfsAylward Production CompanyFIRST REPORT Contractor

C SE NW

SECTION PLAT

 Ft. from N. Line660 Ft. from S. Line660 Ft. from E. Line Ft. from W. Line

CHASE POOL

Location Rig up

Drilling and Remarks:

8"-245'

Drlg. 1610'

RECORD

Cased in., ft.Sand Gas Oil Total Depth

PRODUCTION

1st 24 hrs. Nat. 1st 24 hrs. after shot Gas Cu. Ft.Dry Hole Abandoned

Date

MAY 5 1943 19S. J. LEWIS Scout


Rice

KANSAS

Map No. 49 Sec. 20 Twp. 19 R. 9WWell No. 2 RolfsAylward Production CompanyCOMPLETED Contractor

C SE NW

SECTION PLAT

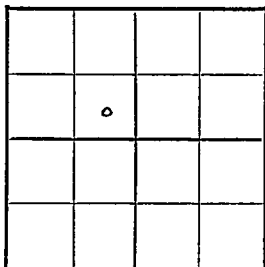 Ft. from N. Line660 Ft. from S. Line660 Ft. from E. Line Ft. from W. Line

CHASE POOL

Location Rig up

Drilling and Remarks:

*Cor 8249**5" 3248**Pump 85 Bbl.**42 5/8*

RECORD

Cased in., ft.Sand Gas Oil Total Depth 3262

PRODUCTION

1st 24 hrs. Nat. 1st 24 hrs. after shot Gas Cu. Ft.Dry Hole Abandoned

Date

MAY 19 1943

19

S. J. LEWIS Scout