

WEST

PLASTIC

SOUTH

Location_____

Drilling Remarks

Rig Up

Drilling Remarks

RECORD

Cased_____in. _____ft.

Sand

Gas

Oil

Total Depth_____

PRODUCTION

1st 24 hrs. Nat.-----

1st 24 hrs. after shot-----

Gas _____ cu. ft. _____

Dry Hole.....

Abandoned_____


Rice

Map No. KANSAS Sec. 20 Twp. 19 R. 9W

Well No. 6- Volkland Farm

Lincoln-Prairie Company

NORTH

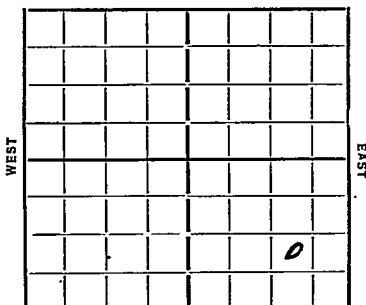

SOUTH

 Ft. from N. Line

990 Ft. from S. Line

990 Ft. from E. Line

 Ft. from W. Line

Date 1/23/35

REPORT

3/13 Location
3/21 12 1/2 159 WOC
3/28 Bly 1910
4/4 " 3115
4/11 7" 3203 Rust
4/18 Sil 3201 T 7 3245
7600' oil Tubing
4/24 Silicious 3201 T 7 3245
1000 acid 1205 Bbls.

COMPLETED

Map No. 49 Sec. 20 Twp. 19 R. 9W

Well No. 6-Volkland

Sinclair-prairie Company

Contractor

FIRST REPORTS

Ft. from N. Line

990 Ft. from S. Line

990 Ft. from E. Line

Ft. from W. Line

SECTION PLAT

			0

Location ✓

Rig up

Drilling and Remarks:

RECORD

Cased in., ft.

Sand

Gas

Oil

Total Depth

PRODUCTION

1st 24 hrs. Nat.

1st 24 hrs. after shot

Gas Cu. Ft.

Dry Hole

Abandoned

Date

3-13-35 192

ORVAL MANSCHRECK

Scout

KANSAS

Map No. 49 Sec. 20 Twp. 19 R. 9W

Well No. 6-Volkland

Sinclair Prairie Company

Contractor

SECTION PLAT

COMPLETED

Ft. from N. Line

990 Ft. from S. Line

990 Ft. from E. Line

Ft. from W. Line

			0

Location

Rig up

Drilling and Remarks:

1000 and

1205 ft

RECORD

Cased in, ft.

Sand Silicem 3201

Gas

Oil

Total Depth 3245

PRODUCTION

1st 24 hrs. Nat.

1st 24 hrs. after shot

Gas Cu. Ft.

Dry Hole

Abandoned

Date

4-24-35 192

ORVAL MANNSCHRECK

Scout