


Map No. **KANSAS** Sec. **20** Twp. **19** R. **9W**
 Well No. **3** *Tolkland* Farm
Sinclair - Prairie Company

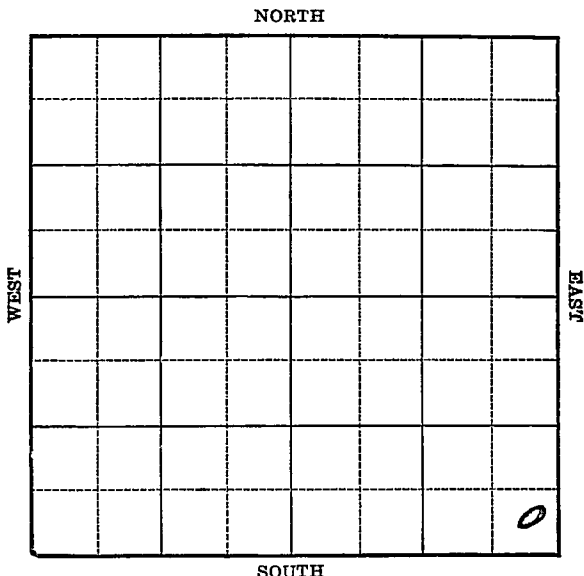

Location _____

Drilling Remarks

RECORD

Cased _____ in. _____ ft.

Sand _____

Gas _____

Oil _____

Total Depth _____

Rig Up _____

Drilling Remarks

PRODUCTION

1st 24 hrs. Nat. _____

1st 24 hrs. after shot _____

Gas _____ cu. ft.


Dry Hole _____

Abandoned _____

Rice

Map No. KANSAS Sec. 20 Twp. 19 R. 9W
Well No. 3 Volkland Farm
Sinclair - Prairie Company

 Ft. from N. Line
330 Ft. from S. Line
330 Ft. from E. Line
 Ft. from W. Line

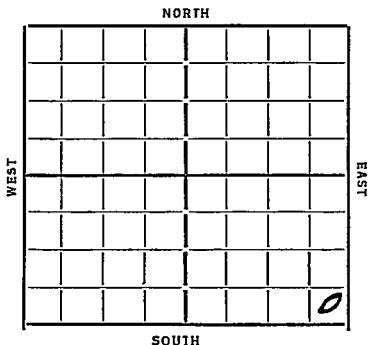

Date 7/24

REPORT

11/21 Ron
11/28 Belly Rig
12/6 Ron Rotary
12/13 Blg 1253 12" 160
12/21 " 2738
12/27 Siliceous 3191 TD 3201 Cum 6"
1/3/35 3000' oil 4 hrs.
1/9 Siliceous 3191 TD 3201
1446 Bbls.

COMPLETED

Map No. 49 Sec. 20 Twp. 19 R. 9WWell No. 3-VolklandSinclair-Prairie Company

Contractor

FIRST REPORTS

SECTION PLAT

Ft. from N. Line

330 Ft. from S. Line330 Ft. from E. Line

Ft. from W. Line

Location

Rig up

Drilling and Remarks:

RECORD

Cased in., ft.

Sand

Gas

Oil

Total Depth

PRODUCTION

1st 24 hrs. Nat.

1st 24 hrs. after shot

Gas Cu. Ft.

Dry Hole

Abandoned

Date

11-21-34 192 ORVAL MANNSCHRECK Scout

Map No. 49 Sec. 20 Twp. 19 R. 9WWell No. 3-VolklandSinclair Prairie Company

Contractor

COMPLETED**SECTION PLAT**

			0

Ft. from N. Line

330 Ft. from S. Line330 Ft. from E. Line

Ft. from W. Line

Location

Rig up

Drilling and Remarks:

1446
bbls**RECORD**

Cased _____ in., _____ ft.

Sand silicious 3191

Gas _____

Oil _____

Total Depth 3201**PRODUCTION**

1st 24 hrs. Nat. _____

1st 24 hrs. after shot _____

Gas _____ Cu. Ft.

Dry Hole _____

Abandoned _____

Date

1-9-35 192 ORVAL MANNSCHRECK Scout