


Section 20 Township 19 Range 9 WWell No. # 4 RolfsCompany Sohio

NORTH

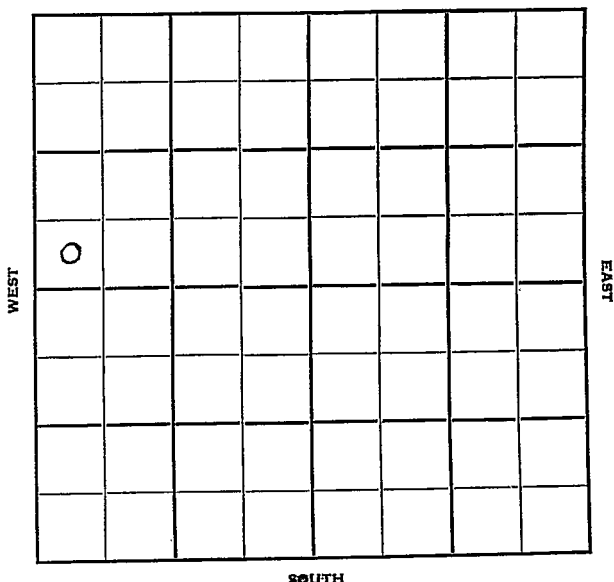

Rice

KANSAS

9 W

Sec. 20 Twp. 19 R.

Well No. # 4 Rolfs Farm

Sohio

Company

B & B Drlg.

Contractor

Chase Pool

Ft. from N. Line

330


Ft. from S. Line

Ft. from E. Line

330

Ft. from W. Line

SW SW NW

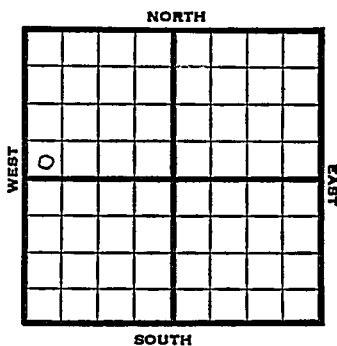

1951

Elev. 1728' REPORT

5/9

8" @ 247'

6/5

Oil Well TD 3234

8" @ 247'

Top 2493 Heeb. 2742

Br Lime 2871 Lans. 2893

DST 2943-56 opn 1 hr Rec. 200' gas
30' gcm

DST 2973-83 opn 1/2 hr Rec. 810' oil
60' mud & oil Arb. 3230

TD 3234 5" @ 3233 21/2178-85 1000 A

5" @ 3233 21/2178-85 1000 A

S/10 boph Comp. 120 bopd

COMPLETED

Sec.	20	(Blk. Twp.)	19	(Sur. Rge.)	9W	Map No.
------	----	----------------	----	----------------	----	---------

Well No. 4 Farm Rolfs

Elev.	Location	SW	SW	NW
-------	----------	----	----	----

0

FIRST REPORT

330 Ft. From W Line Quarter

1st. Report MAY 9 1951

Completion

Remarks .

B & B Drig. - Contr.

Spudding Date _____

Drig. Data Chase Pool

8th @ 247

Chase Pool



Sec.	20	(Blk.) (Twp.)	19	(Sur.) (Rge.)	9W	Map No.
------	----	------------------	----	------------------	----	---------

Well No. 4 Farm Rolfs

Elev.	1728	Location	SW S-W NW
-------	------	----------	-----------

330 Ft. From S Line NW

330 Ft. From W Line Quarter

Ist. Report

Completion JUN 6 1951

Remarks Chase Pool

B & B Drlg. - Contr.

Spudding Date _____

Drilg. Data Oil well TD 3234

8" @ 247 Top. 2493 Heeb. 2742

Br. lime 2871 Lans. 2893 DST 2943-56

open 1 hr. Rec. 200' gas 30' gcm

DST 2973-83 open $\frac{1}{2}$ hr. Rec. 810' oil

60' mud & oil - Arb. 3230 TD 3234

5" @ 3233 21/ 2178-85 1000 A

S/ 10 boph Comp. 120 boph

J. E. TYRA