




Rice

Map No. KANSAS Sec. 20 Twp. 19 R. 9W

Well No. 2 Volkland Farm  
Sinclair - Prairie Company

\_\_\_\_\_ Ft. from N. Line  
330 Ft. from S. Line  
990 Ft. from E. Line  
\_\_\_\_\_ Ft. from W. Line

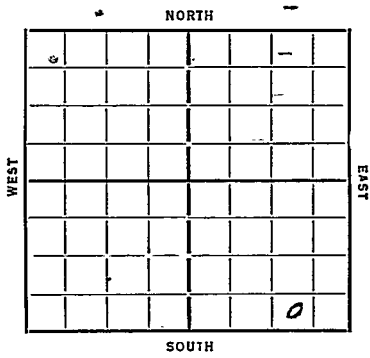

Date 1934 REPORT O. W. D. D

11/7 Location  
11/15 Rot. Rig  
11/22 Dlg 1050 17" 164  
11/28 Fsg 2370  
12/6 — 12/13 —  
12/21 2632 TD Cum back 2170  
12/27 Dlg 2641  
1/3/35 " 2956 KC 2903  
1/10 Silicious 26" ~~3185~~ <sup>3207</sup> WOC  
1/17 Silicious Corrected to 3207  
TD 3220 N 117 Bbls 9 hrs.  
1/24 664 Bbls To Acidize  
1/31 1000 acid  
2/6 Silicious 3207 TD 3223  
1000 acid 949 Bbls.

COMPLETED  
O. W. D. D

9/23/36 - Old total depth 3223'  
Rigging U.P.  
10/11 Drilling 2730'  
10/8 — OVER

10/15-Drlg. 3260'.

10/22-5" @ 372'. drilling.

10/29-Drlg. 3730'.

11/6--T. D. 3748 S. D.

11/10--Sand 3695-3742 Granite 3747

T. D. 3748

Water Disposal Well

130 bbls. water in 30 minutes

**ABANDONED**

Form 26 *Rice* M. Bks. 2-29

Map No. 49 Sec. 20 Twp. 19 R. 9W

Well No. 2 - Valkland

Snclair-prairie Company

Contractor

**FIRST REPORTS**

**SECTION PLAT**

\_\_\_\_\_ Ft. from N. Line

330 Ft. from S. Line

990 Ft. from E. Line

\_\_\_\_\_ Ft. from W. Line

			0

Location

Rig up \_\_\_\_\_

Drilling and Remarks:

**RECORD**

Cased \_\_\_\_\_ in., \_\_\_\_\_ ft.

Sand \_\_\_\_\_

Gas \_\_\_\_\_

Oil \_\_\_\_\_

Total Depth \_\_\_\_\_

**PRODUCTION**

1st 24 hrs. Nat. \_\_\_\_\_

1st 24 hrs. after shot \_\_\_\_\_

Gas \_\_\_\_\_ Cu. Ft.

Dry Hole \_\_\_\_\_

Abandoned \_\_\_\_\_

Date

11-7-34 19

**ORVAL MANNSCHRECK**

Scout


M. J. P. *Handwritten initials*  
M. J. P. *Handwritten initials*

Map No. 49 Sec. 20 Twp. 19 R. 9W

Well No. 2-Volkland

Sinclair-Prairie Company

Contractor

**COMPLETED**

SECTION PLAT

..... Ft. from N. Line  
330 Ft. from S. Line  
990 Ft. from E. Line  
 ..... Ft. from W. Line

			0

Location.....

Rig up.....

Drilling and Remarks:

1000 and

949 bbls

RECORD

Cased..... in., ..... ft.

Sand Silicious 3202

Gas.....

Oil.....

Total Depth 3223

PRODUCTION

1st 24 hrs. Nat.....

1st 24 hrs. after shot.....

Gas..... Cu. Ft.

Dry Hole.....

Abandoned.....

Date

**ORVAL MANNSCHRECK**

2-6-35 192.....

Scout



KANSAS

Map No. 49 Sec. 20 Twp. 19 R. 9W

Well No. 2. Volkland

Simclair - Prairie Company

Contractor

**SECTION PLAT**

			0

\_\_\_\_\_ Ft. from N. Line

320 Ft. from S. Line

990 Ft. from E. Line

\_\_\_\_\_ Ft. from W. Line

**FIRST REPORT**

OWT II

Location W. D. D

Rig up \_\_\_\_\_

Drilling and Remarks:

Old T 13223

Rigging up  
DL

**RECORD**

Cased \_\_\_\_\_ in., \_\_\_\_\_ ft.

Sand \_\_\_\_\_

Gas \_\_\_\_\_

Oil \_\_\_\_\_

Total Depth \_\_\_\_\_

**PRODUCTION**

1st 24 hrs. Nat. \_\_\_\_\_

1st 24 hrs. after shot \_\_\_\_\_

Gas \_\_\_\_\_ Cu. Ft.

Dry Hole \_\_\_\_\_

Abandoned \_\_\_\_\_

Date

SEP 23 1936

19

S. J. LEWIS Scout

*[Handwritten signature]*

Returned	<i>[Signature]</i>
Cards	<i>[Signature]</i>
Receipts	<i>[Signature]</i>
Files	<i>[Signature]</i>
See Receipts	<i>[Signature]</i>
10/1/10	
See Receipts	
Receipts	

# KANSAS

Map No. 49 Sec. 20 Twp. 19 R. 9W.

Well No. 2 Volkland

Sinclair-Prairie Company

Contractor

**ABANDONED**

### SECTION PLAT

			0

\_\_\_\_\_ Ft. from N. Line

330 Ft. from S. Line

990 Ft. from E. Line

\_\_\_\_\_ Ft. from W. Line

**COMPLETED**

Location \_\_\_\_\_

Rig up \_\_\_\_\_

Drilling and Remarks:

Sand 3695-3742

Granite 3747

130 lbs water in 30 minutes

Water Disposal well

### RECORD

Cased \_\_\_\_\_ in., \_\_\_\_\_ ft.

Sand \_\_\_\_\_

Gas \_\_\_\_\_

Oil \_\_\_\_\_

Total Depth 3748

### PRODUCTION

1st 24 hrs. Nat. \_\_\_\_\_

1st 24 hrs. after shot \_\_\_\_\_

Gas \_\_\_\_\_ Cu. Ft.

Dry Hole \_\_\_\_\_

Abandoned \_\_\_\_\_

Date **ABANDONED**

NOV 10 1935

S. J. LEWIS Scout

??

*Paul*

Returned	.....
Cards	<i>Paul</i> .....
Tracing	<i>Joe</i> .....
France Map	.....
Scarborough Map	.....
Moody Map	.....
Scarborough Plat Book	.....
Moody Plat Book	.....