


Rice

Form 51-5M-11-31-Palace

Map No. **KANSAS** Sec. 20 Twp. 19 R. 9W

Well No. 1 Volkland Farm
Keith et al Company

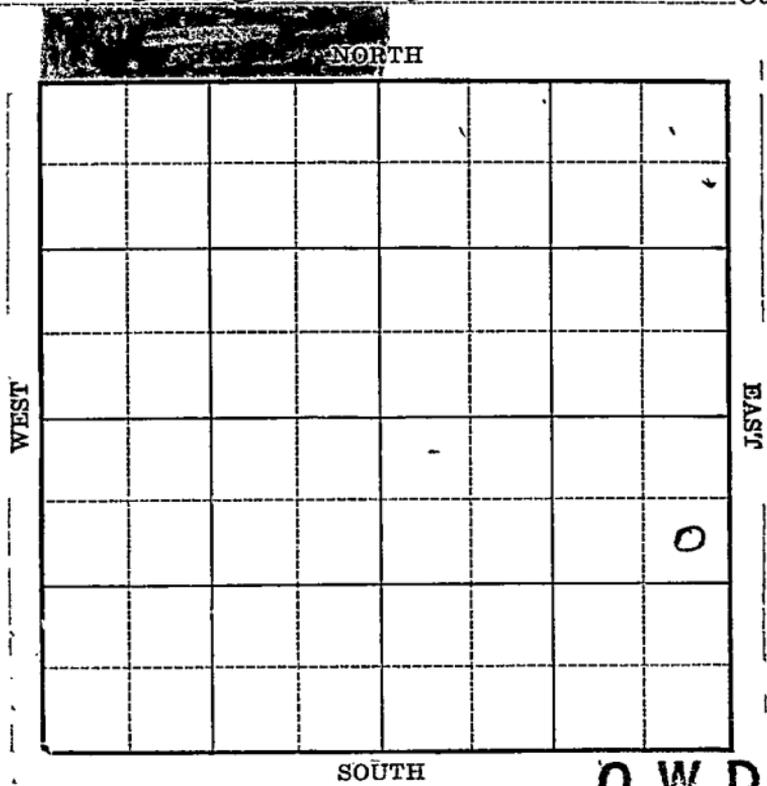

O. W. D. D

Location _____

Drilling Remarks _____

RECORD

Cased _____ in. _____ ft.

Sand _____

Gas _____

Oil _____

Total Depth _____

Rig Up _____

Drilling Remarks _____

PRODUCTION

1st 24 hrs. Nat. _____

1st 24 hrs. after shot _____

Gas _____ cu. ft. _____

Dry Hole _____


Abandoned _____

Rice

Map No. **KANSAS** Sec. 20 Twp. 19 R. 9^W

Well No. 1 Volkland Farm
Keith et al Company

990 Ft. from N. Line
_____ Ft. from S. Line
330 Ft. from E. Line
_____ Ft. from W. Line

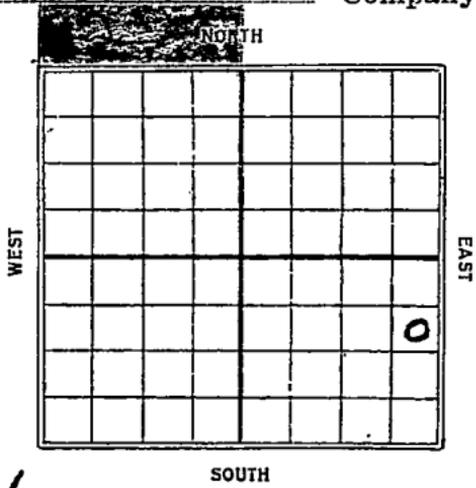

Special

Date	REPORT	O. W. D. D
4/18	Cellar	
4/26	— 5/3 — 5/10 —	
5/18	— 5/25 — 5/31 —	
6/7	Bldg. Rig	
6/14	—	
6/21	Rig	
6/28	— 7/5 — 7/12 —	
7/19	RU	
7/26	15" 552	
8/2	Dlg 1280	
8/9	" 1875 13 3/8 1593	
8/17	Show gas 2005-10 10" 2200 C.O.	
8/23	KCL 2900 Dlg 2915	
8/30	57 3150	
9/6	8" 3150 Silicious 3206	
	TD 3225 2800' oil No test	
9/13	Pump 362 Bbls 17 hrs.	
9/20	1000 Gal acid WOF	
9/26	Silicious 3206 TD 3225	
	1000 acid 457 Bbls.	

COMPLETED

(OVER)

1935

O. W. D. D

3/20 Row up.

3/28 Dly 3242

4/3 77 3242
1043 Bbls.

COMPLETED

Map No. 49 Sec. 20 Twp. 19 R. 9W

Well No. 1-Volkland

Keith Company

Contractor

SPECIAL

Handwritten signature

SECTION PLAT

990 Ft. from N. Line

..... Ft. from S. Line

330 Ft. from E. Line

..... Ft. from W. Line

			0

FIRST REPORT

Location.....

Rig up.....

Drilling and Remarks:

cellar

RECORD

Cased..... in, ft.

Sand.....

Gas.....

Oil.....

Total Depth.....

PRODUCTION

1st 24 hrs. Nat.....

1st 24 hrs. after shot.....

Gas..... Cu. Ft.

Dry Hole.....

Abandoned.....

Date

4-18-34 192.....

ORVAL MANNSCHRECK
..... Scout

Returned *RDJ*
Cards *RDJ*
Tracing *RDJ*
France Map *X*
Moody Map *X*
Scarborough Port Book
Moody Port Book

Map No. 49 Sec. 20 Twp. 19 R. 9W

Well No. 1-Volkland

Keith et al

Company

Contractor

COMPLETED

SECTION PLAT

			0

990 Ft. from N. Line

_____ Ft. from S. Line

330 Ft. from E. Line

_____ Ft. from W. Line

Location _____

Rig up _____

Drilling and Remarks:

1000 acid

457 bbls

RECORD

Cased _____ in., _____ ft.

Sand silicious 3206

Gas _____

Oil _____

Total Depth 3225

PRODUCTION

1st 24 hrs. Nat. _____

1st 24 hrs. after shot _____

Gas _____ Cu. Ft.

Dry Hole _____

Abandoned _____

Date

9-26-34 19

ORVAL MANNSCHRECK

Scout

no water

RF
OK

F
X

X

Map No. 49 Sec. 20 Twp. 19 R. 9W

Well No. 1-Volkland

Keith et al Company

Contractor

FIRST REPORTS

SECTION PLAT

990 Ft. from N. Line

..... Ft. from S. Line

330 Ft. from E. Line

..... Ft. from W. Line

OTN

			0

Location.....

Rig up.....

Drilling and Remarks:

OTN 3225
Rig n up

RECORD

Cased..... in., ft.

Sand.....

Gas.....

Oil.....

Total Depth.....

PRODUCTION

1st 24 hrs. Nat.....

1st 24 hrs. after shot.....

Gas..... Cu. Ft.

Dry Hole.....

Abandoned.....

Date

3-20-35 192

ORVAL MANSCHRECK

Scout

no wall

Returned	<i>CPA</i>
Cards	<i>CPA</i>
Tracing	<i>Miss</i>
France Map	X
Scarborough Map	X
Moody Map	X
Scarborough Plat Book	
Moody Plat Book	

Map No. 49 Sec. 20 Twp. 19 R. 9W

Well No. 1 - Volkland

Keith et al Company

Contractor

COMPLETED

SECTION PLAT

			0

990 Ft. from N. Line

..... Ft. from S. Line

330 Ft. from E. Line

..... Ft. from W. Line

OWD

RECORD

Location.....

Cased..... in., ft.

Rig up.....

Sand.....

Drilling and Remarks:

Gas.....

Oil.....

Total Depth 324 1/2

PRODUCTION

1043 bbls.

1st 24 hrs. Nat.....

1st 24 hrs. after shot.....

Gas..... Cu. Ft.

Dry Hole.....

Abandoned.....

Date

ORVAL MANNSCHECK

4-3-35 192

Scout

no wall

Returned	<i>ADJ</i>
Cards	<i>ADJ</i>
Tracing	<i>ADJ</i>
France Map	<i>X</i>
Scarborough Map	<i>X</i>
Moody Map	<i>X</i>
Scarborough Plot Book	
Moody Plot Book	