


Rice

Map No. KANSAS Sec. 20 Twp. 19 R. 9W

Well No. 3 - Volkland Farm
Keith et al Company

990 Ft. from N. Line
____ Ft. from S. Line
990 Ft. from E. Line
____ Ft. from W. Line

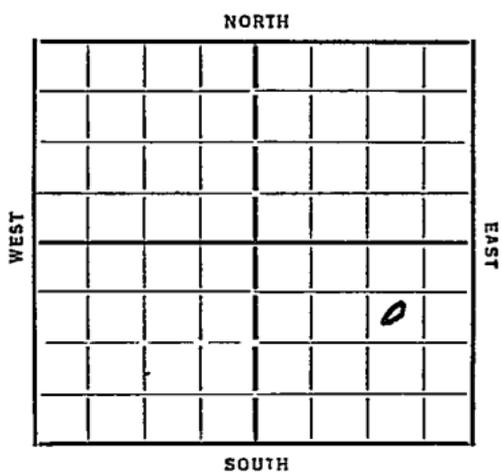

Date 7/35 REPORT

3/27 Location
4/4 Cella
4/11 _____
4/18 Material
4/26 Rig
5/2 Rgn
5/9 Dlg 825 12" 815
5/16 " 1750
5/23 " 1885
5/29 10" 1888 8" 2324
KQ 2903 50 2985-95
Dly 3030
6/6 Cong 3208 6" 3220
Sill 3220 T7 3259
6/13 642 Bbls Net 1000 acid
6/19 Siliceous 3220 T7 3259
1000 acid 642 Bbls

COMPLETED

Map No. 49 Sec. 20 Twp. 19 R. 9W

Well No. 3-Valkland

Keith et al Company

Contractor

FIRST REPORT SECTION PLAT

990 Ft. from N. Line

..... Ft. from S. Line

990 Ft. from E. Line

..... Ft. from W. Line

			0

Location

Rig up

Drilling and Remarks:

RECORD

Cased.....in.,ft.

Sand.....

Gas.....

Oil.....

Total Depth.....

PRODUCTION

1st 24 hrs. Nat.....

1st 24 hrs. after shot.....

Gas.....Cu. Ft.

Dry Hole.....

Abandoned.....

Date

ORVAL MANNSCHRECK

3-27-35 192.....

Scout

Map No. 49 Sec. 20 Twp. 19 R. 9^w

Well No. 3-Volkhard

Keith et al Company

Contractor

COMPLETED

SECTION PLAT

990 Ft. from N. Line

_____ Ft. from S. Line

990 Ft. from E. Line

_____ Ft. from W. Line

			0

Location _____

Rig up _____

Drilling and Remarks: .

1000 and
642 bbls

RECORD

Cased _____ in., _____ ft.

Sand siliceous 3220

Gas _____

Oil _____

Total Depth 3259

PRODUCTION

1st 24 hrs. Nat. _____

1st 24 hrs. after shot _____

Gas _____ Cu. Ft.

Dry Hole _____

Abandoned _____

Date

6-19-35 192

ORVAL MANNSCHRECK

Scout