


Rice

Map No. 54545 Sec. 20 Twp. 19 R. 9^W

Well No. 4 - Volkland Farm
Keith et al Company

990 Ft. from N. Line
____ Ft. from S. Line
____ Ft. from E. Line
990 Ft. from W. Line

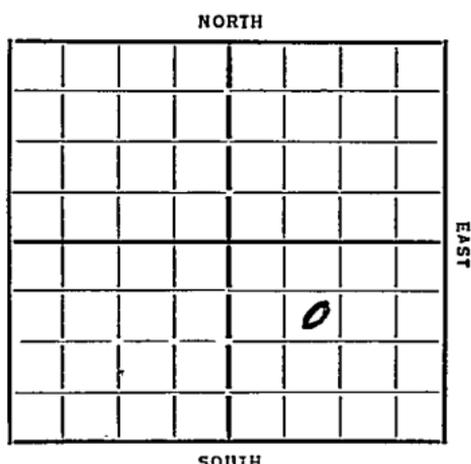

Elev. 1725

Date 1935 REPORT

5/28 Cellar
6/6 Rig
6/13 _____
6/20 Dlg 350 20" 120
6/28 " 1725 10" 1887
7/3 " 2345 8" 2241
7/4 " 3085 20 2955-60
7/18 6" 3225 Sil 3235
Dib 3255 T 3260
2000' dib 1100' W.
8/8 6" 3225 3260 T.
8/15 _____
8/21 Sil 3235 T 3260
410 Blw.

COMPLETED

Map No. K49 Sec. 20 Twp. 19 R. 9W

Well No. H-Volkeard

Keith et al Company

Contractor

FIRST REPORTS

SECTION PLAT

990 Ft. from N. Line

..... Ft. from S. Line

..... Ft. from E. Line

990 Ft. from W. Line

		0	

Location.....

Rig up.....

Drilling and Remarks:

Clear

RECORD

Cased..... in., ft.

Sand.....

Gas.....

Oil.....

Total Depth.....

PRODUCTION

1st 24 hrs. Nat.....

1st 24 hrs. after shot.....

Gas..... Cu. Ft.

Dry Hole.....

Abandoned.....

Date

5-28-35 192.....

ORVAL MANSCHRECK

Scout

Map No. 40 Sec. 20 Twp. 19 R. 9W

Well No. H - Volkland
Keith et al Company

Contractor

COMPLETED

SECTION PLAT

990 Ft. from N. Line
 Ft. from S. Line
 Ft. from E. Line
990 Ft. from W. Line

		0	

Location.....

Rig up.....

Drilling and Remarks:

410 bbls

RECORD

Cased..... in., ft.
 Sand: Oil 3235
 Gas.....
 Oil.....
 Total Depth 3260

PRODUCTION

1st 24 hrs. Nat.....
 1st 24 hrs. after shot.....
 Gas..... Cu. Ft.
 Dry Hole.....
 Abandoned.....

Date

8-21-35 192.....

ORVAL MANNSCHRECK

Scout