


Section 20 Township 19 Range 2W

Well No. #1 Johnson

Company Aladdin Petroleum

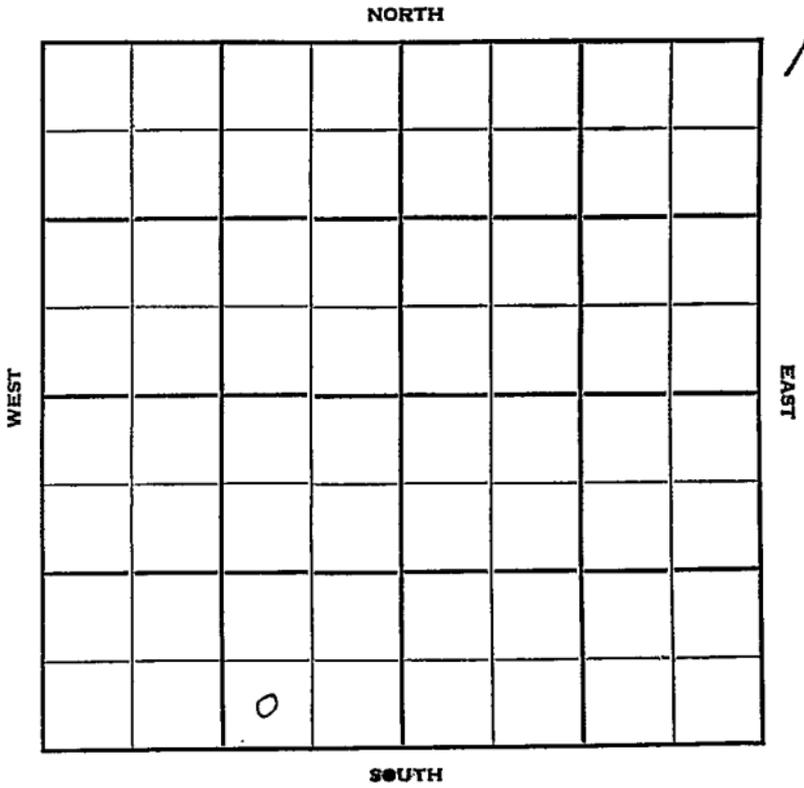

Sec. 20 Twp. 19 R. 2W

Well No. #1 Johnson Farm

Aladdin Petroleum, Company

Contractor


_____ Ft. from N. Line

330' Ft. from S. Line

990' Ft. from E. Line

_____ Ft. from W. Line

SW SE SW

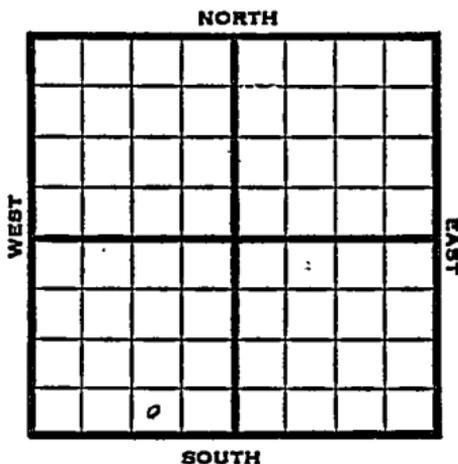

1950	Elev. 1513' REPORT
12/20	Location
1951	
1/3	Spud 12-20-50
	D&A TD 3605
	8" @ 130' KC 2318' Miss lime 3032'
	Kinderhook 3189' Hunton 3320'
	Maq. 3344 Viola 3487 Simp 3562
	DST 3558-65 opn 30 min Rec. 20' mud
	Arb. 3580 TD 3605 D&A
	ABANDONED

