


KANSAS

Section 20 Township 19 Range 10 W

Well No. # 6 Roelfs

Company Continental Oil

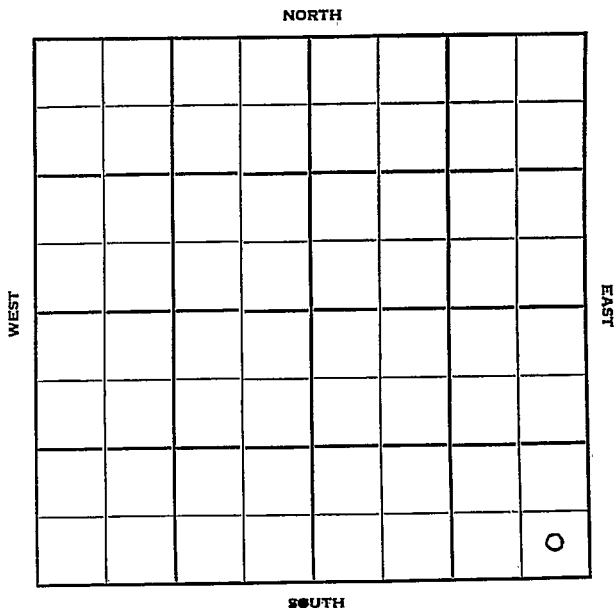

Rice

KANSAS

Sec. 20 Twp. 19 R. 10 W ✓

Well No. # 6 Roelfs Farm

Continental Oil Company

Contractor

Silica Pool


 Ft. from N. Line

330 Ft. from S. Line

330 Ft. from E. Line

 Ft. from W. Line

SE SE SE

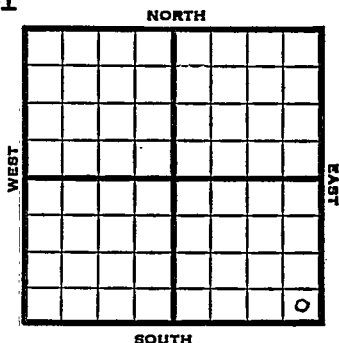

1951 Elev. 1767' REPORT

5/9 Location

7/3 Spud 5-12-51 Oil well TD 3265'
10" @ 350 Lans. 2972' Arb. 3260'
TD 3264' 5" @ 3261' DD 3265'
S/33 BO 8 hr.
Comp. 84 BOPD

COMPLETED

County **Rice** State **Kansas**

Sec. 20 (Blk. Twp.) 19 (Sur. Rge.) 10W Map No.

Operator Continental Oil

Well No. 6 Farm Roelfs

Elev: 1767 Location SE SE SE

FIRST REPORT

330 Ft. From S Line SE

330 Ft. From **E** Line Quarter

1st. Report MAY 9 1951

Completion

Remarks

Spudding Date

Drlg. Data

Silica Pool

Location

J. E. TYRA

