

**KANSAS**

Rice

Section 20 Township 19 Range 10WWell No. 1 GossmanCompany G R Lauck

Silica

NORTH

|  |  |  |  |  |  |  |   |
|--|--|--|--|--|--|--|---|
|  |  |  |  |  |  |  |   |
|  |  |  |  |  |  |  |   |
|  |  |  |  |  |  |  | o |
|  |  |  |  |  |  |  |   |
|  |  |  |  |  |  |  |   |
|  |  |  |  |  |  |  |   |
|  |  |  |  |  |  |  |   |
|  |  |  |  |  |  |  |   |

WEST

EAST

SOUTH

KANSAS

Rice

Sec. 20 Twp. 19 R. 10W ✓

Well No. #1 Gossman Farm

D. R. Lauck Company


Silica Pool

           Ft. from N. Line

990' Ft. from S. Line

330' Ft. from E. Line

           Ft. from W. Line

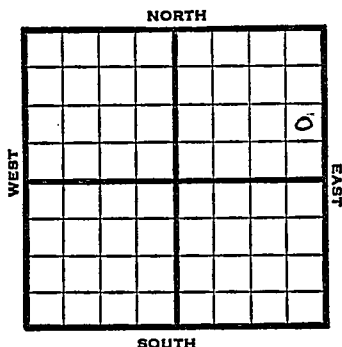

NE SE NE

SOUTH

1949

Elev 1772'

R E P O R T

4/6 Location  
4/12 10" @ 132'  
Drlg 2455'  
4/20 Lansing 29508  
Cong 3227-80'  
TD 3280'  
5" @ 3270'  
4/27 TD 3284  
Swb 15 bbls oil PH  
5/4 TD 3284'  
Cong 3227'  
5" @ 3270'  
Pump 100 oil Pot  
41<sup>st</sup> Gr.  
Comp

**COMPLETED**

Map No. \_\_\_\_\_ Sec. 20 Twp. 19 R. 10W

Well No. 1 Gossman

D. R. Lauck Company

FIRST REPORT Contractor

NE SE NE

SECTION PLAT

\_\_\_\_\_ Ft. from N. Line

990 Ft. from S. Line

330 Ft. from E. Line

\_\_\_\_\_ Ft. from W. Line

Rice County

|  |  |  |   |
|--|--|--|---|
|  |  |  |   |
|  |  |  | o |
|  |  |  |   |
|  |  |  |   |

Location X

Rig up

Drilling and Remarks:

RECORD

Cased \_\_\_\_\_ in., \_\_\_\_\_ ft.

Sand \_\_\_\_\_

Gas \_\_\_\_\_

Oil \_\_\_\_\_

Total Depth \_\_\_\_\_

PRODUCTION

1st 24 hrs. Nat. \_\_\_\_\_

1st 24 hrs. after shot \_\_\_\_\_

Gas \_\_\_\_\_ Cu. Ft.

Dry Hole \_\_\_\_\_

Abandoned \_\_\_\_\_

Date

APR 6 1949 19 S. J. LEWIS Scout

Map No. K 46 Sec. 20 Twp. 19 R. 10W

Well No. 1 Gossman

D. R. Lauck Company

COMPLETE Contractor

NE SE NE

E. 1972  
SECTION PLAT

           Ft. from N. Line

990 Ft. from S. Line

330 Ft. from E. Line

           Ft. from W. Line

|  |  |  |   |
|--|--|--|---|
|  |  |  |   |
|  |  |  | d |
|  |  |  |   |
|  |  |  |   |
|  |  |  |   |

Rice County

Location                                 

Rig up                                 

Drilling and Remarks:

Aug 3227

51 32270

Pump 100 oil 32270

41 32270

RECORD

Cased            in.,            ft.

Sand                                 

Gas                                 

Oil                                 

Total Depth 32274

PRODUCTION

1st 24 hrs. Nat.                                 

1st 24 hrs. after shot                                 

Gas                                  Cu. Ft.

Dry Hole                                 

Abandoned                                 

Date

MAY 4 1949 19

S. J. LEWIS Scout