


Section 20 Township 19 Range 11W

Well No. #1 Schartz "B"

Company Alpine Oil & Royalty

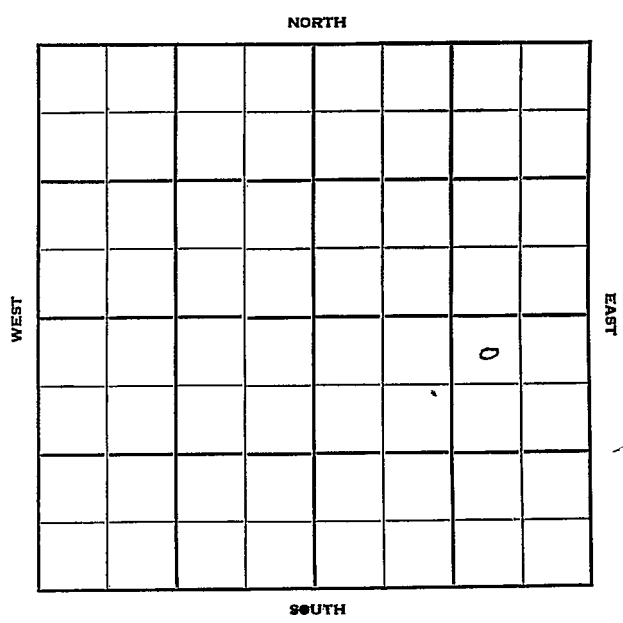

O.W.W.O.

KANSAS

Barton
19

11W ✓

Sec. 20 Twp. R.

Well No. #1 Schartz "B" Farm

Alpine Oil & Royalty Company

Quaker Drlg. - Contr. Contractor

Prairie View Pool


330' Ft. from N. Line

Ft. from S. Line

990' Ft. from E. Line

Ft. from W. Line

NW NE SE

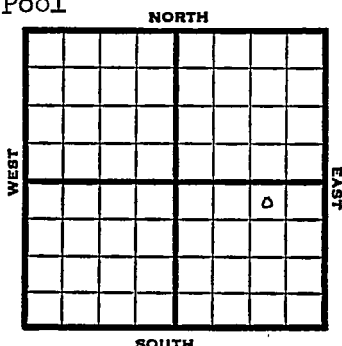

1950

Elev. 1786'

REPORT

12/13

Location

1951

3/14

Spud 12-12-50

D & A TD 3405

8" @ 226

Anhy 572-605, Heeb. 2941, Br. lime 3061, Lans 3077,

DST 3079-3122 open 1 hr. Rec. 1640' gas, 1030' O & GCM

Cong. 3346, Arb. 3357-69

5" @ 3361

TD 3405 water D & A

ABANDONED

1951

6/13

O.W.W.O.

Oil well TD 3092'

Lans. 3077' Cong 3346' Arb. 3357'

OTD 3405' 5" @ 3361' DC 3405'


CO to 3092'

Comp. 24 BOPD from KC

FIRST REPORT

COMPLETED

County Barton State Kansas
 Sec. 20 (Blk.) 19 (Sur.) 11W Map No. _____
 Operator Alpine Oil & Royalty
 Well No. 1 Farm Schartz "B"
 Elev. 1786 Location NW NE SE

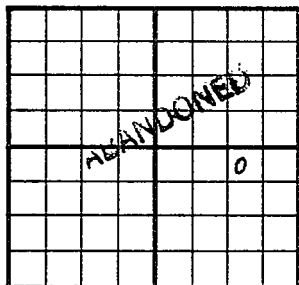

330 Ft. From N Line SE
990 Ft. From E Line Quarter

1st. Report

Completion MAR 14 1951

Remarks Prairie View Pool

Quaker Drlg. - Contr.

Spudding Date 12-12-50

Drlg. Data D & A TD 3405

8" @ 226 Anhy 572-605 Heeb. 2941

Br. lime 3061 Lans. 3077 DST 3079-3122


open 1 hr. Rec. 1640' gas 1030' o & gcm

Cong. 3346 Arb. 3357-69 5" @ 3361

TD 3405 water D & A

J. E. TYRA

County Barton State Kansas
 Sec. 20 (Blk. 19 (Sur. 11W Map No.
 (Twp. 19 (Rge. 11W
 Operator Alpine Oil & Royalty
 Well No. 1 Farm Schartz "B"
 Elev. 1786 Location NW NE SE

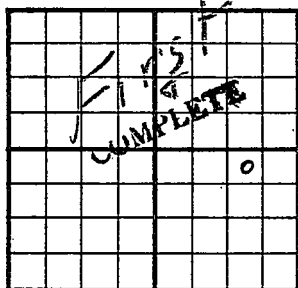

330 Ft. From N Line SE
990 Ft. From E Line Quarter

1st. Report

Completion JUN 13 1951

Remarks

OWWO

O.W.P.B.

Spudding Date

Drlg. Data Oil well TD 3092

Lans. 3077 Cong. 3346 Arb. 3357

OTD 3405 5" @ 3361 DC 3405 TD

CO to 3092 Comp. 24 bopd from KC

J. E. TYRA