


DX 78-1 Barton

KANSAS

Section 20 Township 19 Range 13W

Well No. #1 Ed Kirkman

Company Frontier Oil

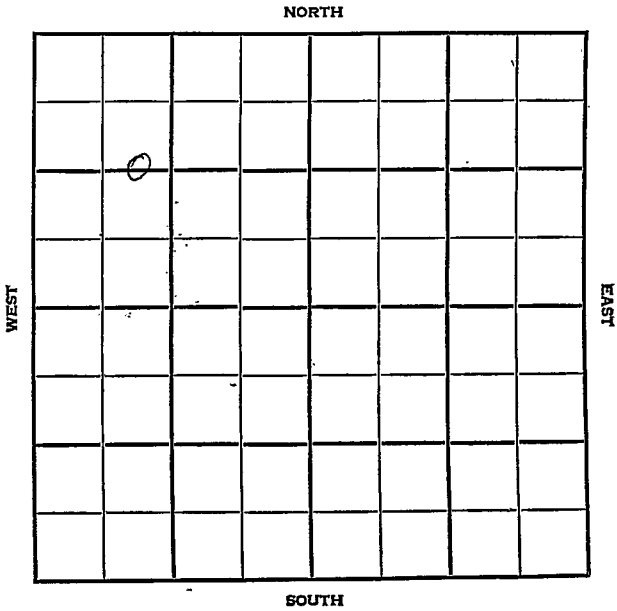

Barton

KANSAS

SEC. 20	TWP. 19	R. 13W
------------	------------	-----------

WELL NO.

#1 Ed Kirkman

FARM

COMPANY

Frontier Oil

CONTRACTOR

Coppinger

Gt. Bend Twst


\_\_\_\_\_ Ft. from N. Line

\_\_\_\_\_ Ft. from S. Line

\_\_\_\_\_ Ft. from E. Line

\_\_\_\_\_ Ft. from W. Line

C E $\frac{1}{2}$  W $\frac{1}{2}$  NW

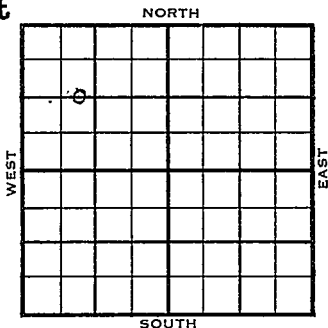

1956

ELEVATION  
1856

REPORT

3-21 Location

4-11 Comm. 3-23-56  
 8 5/8" @ 768 w/350  
 DST 3235-80 op 1 hr. rec. 36' mud,  
 625/20"  
 D & A  
 Anh. 758  
 H. 3087  
 BL. 3185  
 L. 3197  
 A 3482  
 TD 3495

**ABANDONED**

County Barton Elev. \_\_\_\_\_  
 Sec. 20 Twp. 19 Rge. 13W  
 Company Frontier Oil  
 Farm Name Ed Kirkman No. 1

TOPS	DEPTH	LOG	DATUM
Anh.			
Tr.			
H.			
Tr.			
Dg.			
BL.			
L.			
K.C.			
B.K.C.			
Ce.			
C.			
M.			
M.			
K.			
Mz.			
Ma.			
V.			
S.			
S.			
A.			
R.			
PE.			
G.			
T.D.			

Loc. in Sec. C E 1/2 W 1/2 NW

Geol. \_\_\_\_\_  
 Contr. Coppinger

Pool Gt. Bend Twst.

APR 21 1956  
 FIRST REPORT

Date Comm. \_\_\_\_\_  
 Location \_\_\_\_\_

13

Co.  
 Lse.  
 No.  
 Sec.  
 T.  
 R.

County Barren Elev. 7856  
 Sec. 20 Twp. 19 Rge. 13W  
 Company Frontier Oil  
 Farm Name Ed Kirkman No. 1

TOPS	DEPTH	LOG	DATUM	Loc. in Sec.
Anh.	<u>758</u>			<u>C E<sup>1</sup>/<sub>2</sub> W<sup>1</sup>/<sub>2</sub> NW</u>
Tp.				
H.	<u>3087</u>			
Tr.				
Dg.				
Bl.	<u>3185</u>		<u>1329</u>	
L.	<u>3197</u>		<u>1341</u>	
K.C.				Geol. _____
B.K.C.				Contr. _____
Ce.				<u>Coppinger</u>
C.				
M.				Pool _____
M.				<u>Gt. Bend twst</u>
K.				
Mz.				
Ma.				
V.				
S.				
S.				
A.	<u>3482</u>		<u>1626</u>	
R.				
PE.				<b>ABANDONED</b>
G.				
T.D.	<u>3495</u>			

Date Comm. 3-23-56 APR 1 1 1956

8 5/8" @ 768/350 DST 3235-80  
open 1 hr. rec. 36' mud 625/20"

D & A